

Name - Herminia Marsolais
 Address 37 Parker Street, Lexington, Mass.
 7 Calvin St.

Service No. ~~30~~ 449

Location 7 Calvin Street

Kind of Pipe Size Size of Main

~~Repairs~~ ~~Renewals~~ New Service

Location

Date	Material	Amount	Total	Date	Amount
1939 May 9 SM 5-11-39	16 hrs/ @ 60¢		9 60	May 4, 1939	Deposited 25.00
	10% Overhead		96		
	33' 3/4" Copper Tubing @ 20¢		6 60		
	1 3/4" S. & W.		3 75		
	1 3/4" Union (3 part)		1 10		
	Trucking, 2 hrs. @ 75¢		1 50		
			<hr/> 23 51		
	Charge Flat Rate	\$25.00			
	Labor				

DATE May 4, 1939

TOWN OF LEXINGTON—BOARD OF PUBLIC WORKS
WATER DIVISION

The undersigned applies for a supply of water at No. 7 Caloun St. and hereby agrees to comply with the rules and regulations as now, or at any future time, established by the Board of Selectmen.

Am't. of Estimate \$ 74⁰⁰

Owner Herminia Massolas
Per C.H.M.


Am't. Paid \$ _____

Address 37 Parker St.

Builder _____

Lexington, Mass

Sketch of Service Here

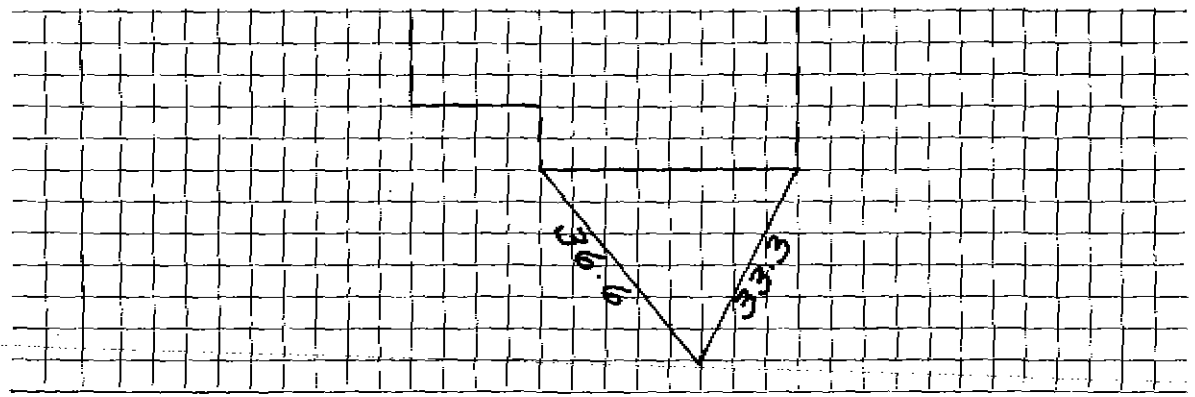

Connection made in _____ Street. Work completed _____ 19

Remarks: