




TOWN OF LEXINGTON - BOARD OF PUBLIC WORKS

WATER DIVISION

DATE \_\_\_\_\_

Sketch of Service Here

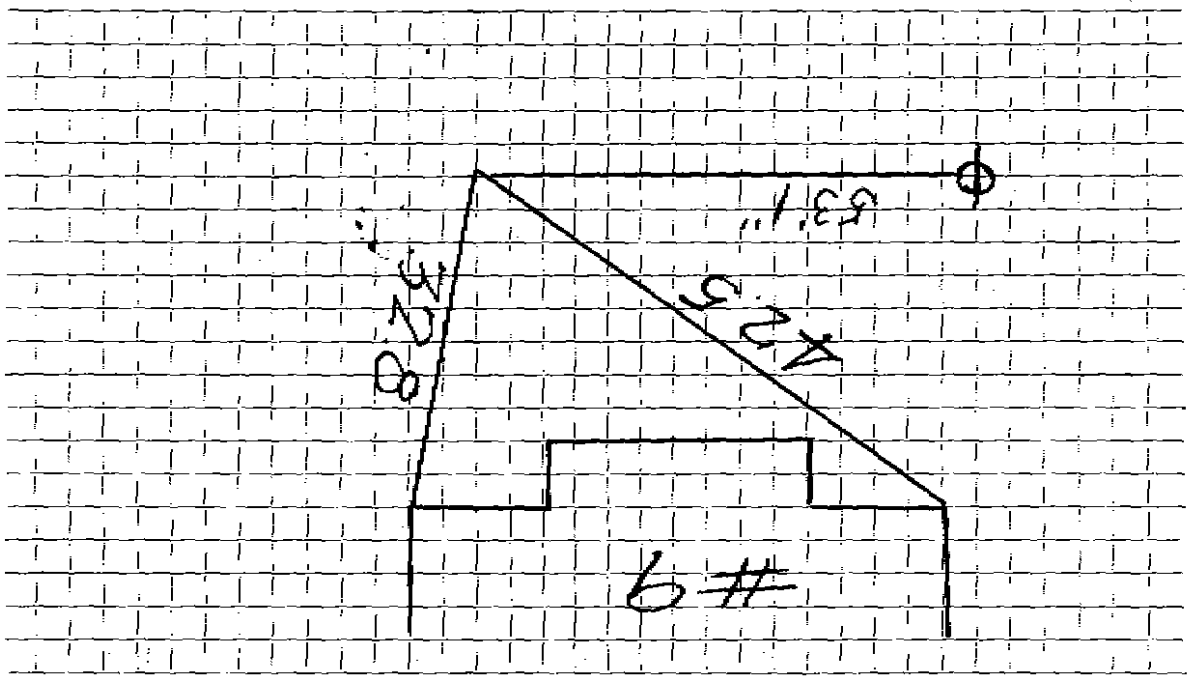

Connection made in \_\_\_\_\_ Street. Work completed \_\_\_\_\_  
Remarks: Original service installed 4/22/32