

## WATER SERVICE RECORD

Name George Cogswell

Service No. 204

Address 4 Camden Street

Location

~~xRepair~~—Renewal—New Service


Comm. 12-9-57

Date	Material	Amount	Total	Date	Amount	
9/19/57	labor	2 15		9-18-57	Deposit	30 00
	10% overhead	22		12-2-57	Refund	11 04
			2 37		NON CHARGE	\$ 18 96
	29' 3/4" copper tubing @ .375	10 88			3' 3/4" copper tubing @ .375	1 13
	1 3/4" C x 1/2 IWH stop & waste	4 96			1 3/4" C curb cock	5 94
	1 hr. trucking @ .75		75		1 box & rod	4 62
			18 96		1 1" nipple	49
					1 1" C x 1" 1/2 part Union	1 40
					1 1/2 straight tail pc.	50
					1 1/2 offset tail pc.	50
						14 58

DATE \_\_\_\_\_

**TOWN OF LEXINGTON — BOARD OF PUBLIC WORKS**  
**WATER DIVISION**

Sketch of Service Here

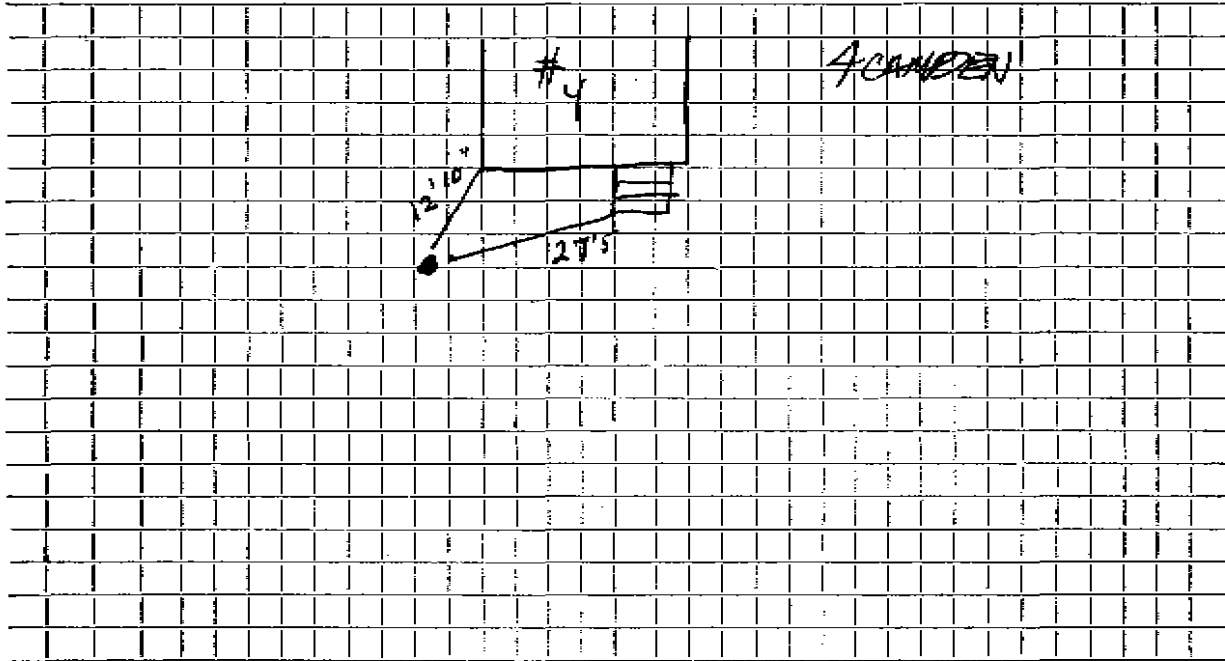

Connection made in ..... Street. Work completed .....

Remarks: .....

.....

.....