


DATE _____

TOWN OF LEXINGTON — BOARD OF PUBLIC WORKS

WATER DIVISION

Sketch of Service Here

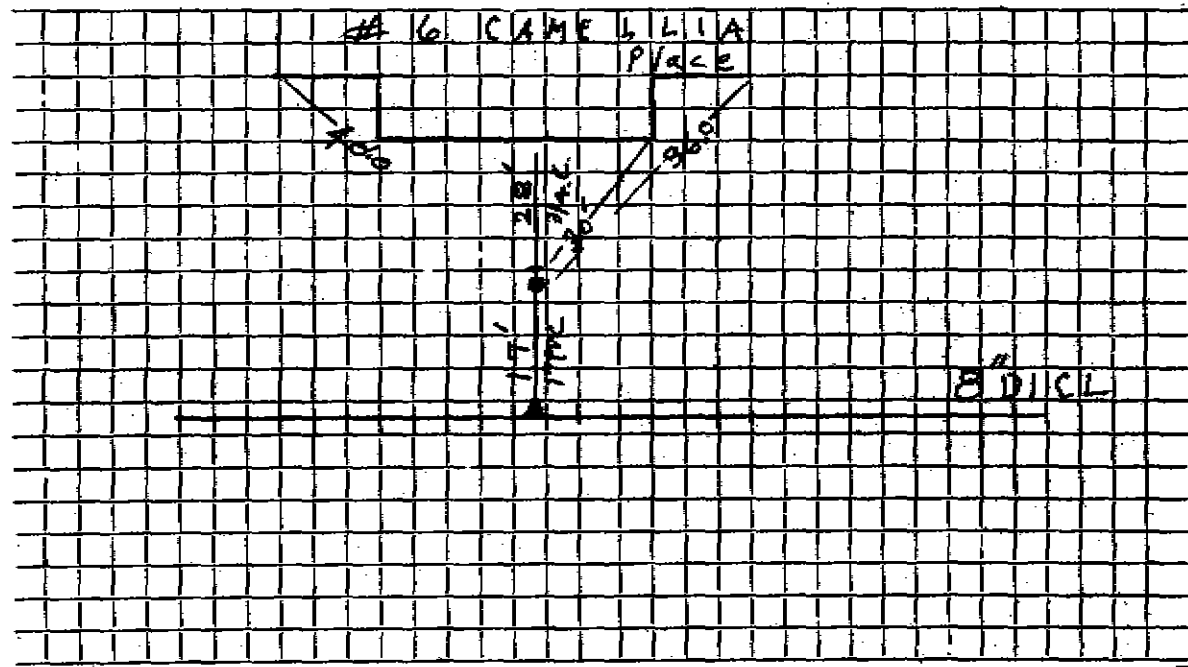

Connection made in Camellia Place Street.

Work completed 4/26/07 (Cedrons)

Remarks: 12" MAIN To curb top of house