


DATE _____

TOWN OF LEXINGTON — BOARD OF PUBLIC WORKS

WATER DIVISION

Sketch of Service Here
old main main OIL

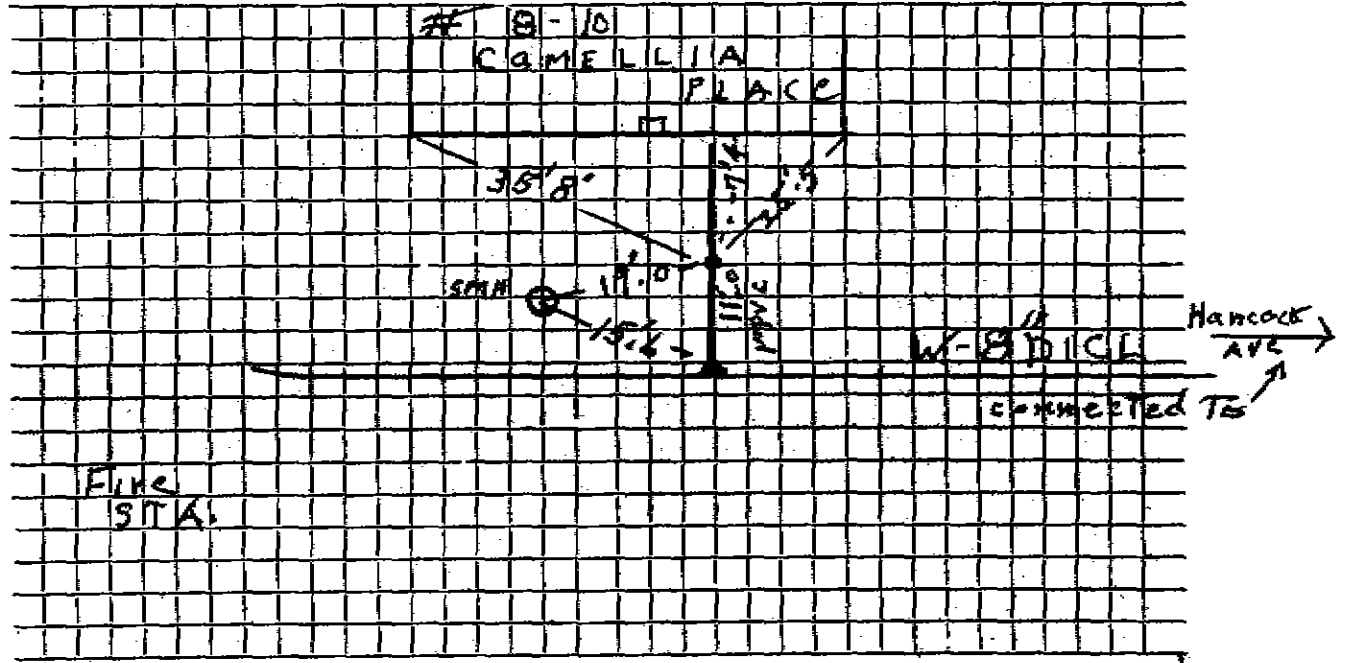

Connection made in _____ Street. Work completed 2007 Cedvone

Remarks: 1" PVC MAIN To Cook Stop