

#154

WATER SERVICE RECORD

Name Leeland Const. Co.

Service No. 71

Address 8 Camellia Place TREMBLAY BULD

Location Lexington


~~REPAIR WORK~~ New Service COM. 5-18-53

Date	Material	Amount	Total	Date	Amount
4/29/53	Labor	1 75		4-14-53	25 -
	10% overhead	18	1 93	5-18-53	8 12
	30'-3/4" Copper Tubing @.34		10 20		NON-CHARGE
	1-3/4" C x 1/2 I.W.H. stop & waste		4 00	4/29/53	Labor
	1 Hr. Trucking		75		21'-3/4" Copper Tubing @.34
			16 88		1-3/4" C. Corp-cock
					1-3/4" C x 3/4" C. Curb-cock
					1-Box & Rod
					1-1/2 offset tail piece
					1-1/2 straight tail piece
					1 Hr. Trucking
					23 54

TOWN OF LEXINGTON — BOARD OF PUBLIC WORKS

WATER DIVISION

Sketch of Service Here

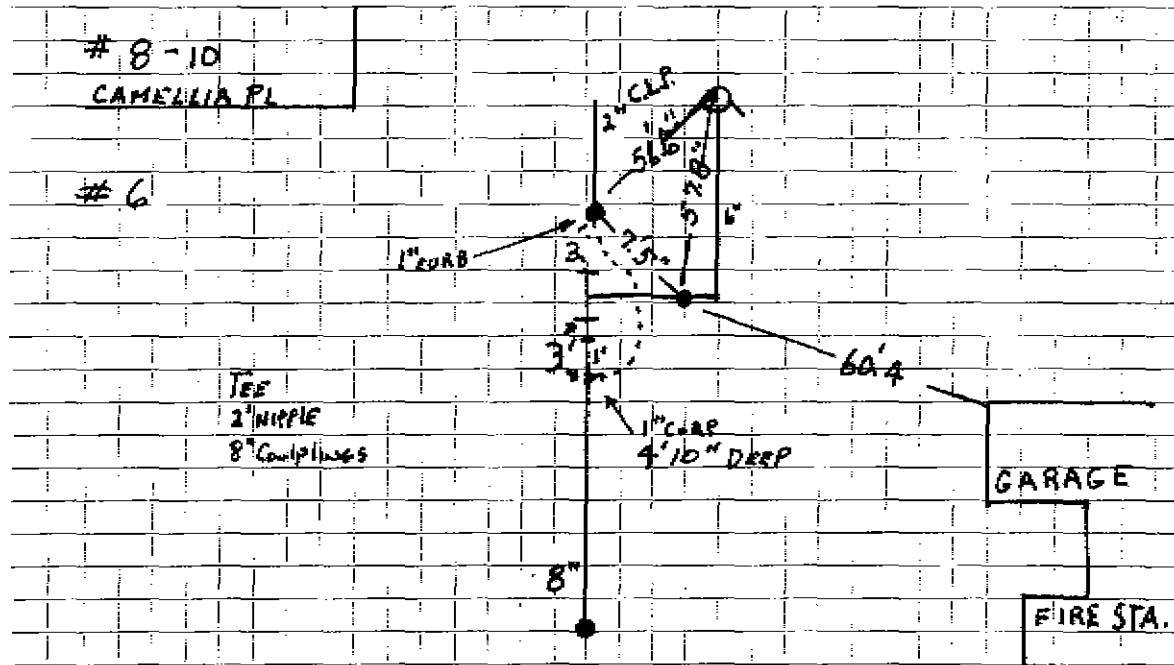

Connection made in _____ Street. Work completed _____

Remarks: 1" CURB Will shut # 6 # 8+10 1" COPPER GOES UNDER 6" HYD FEED