

Name Dana T. Lowell

Service No. ~~5~~ 452

Address ~~25 Whiting Road, Wellesley Hills, Mass.~~

Location 1 Candlewick Close

Kind of Pipe

Size

Size of Main

~~Repair - Renewal~~ New Service

Location

Date	Material	Amount	Total	Date		Amount
2/16/38	2 hrs. @ 60¢		1 20	February 1, 1938	Paid	22 00
<i>Contract</i>	34' 3/4" Cop. Tubing @ 25¢		8 50			
	1 3/4" S. & W.		3 75			
	2 hrs. trucking @ 75¢		<u>1 50</u>			
			14 95			
	Flat Rate:					
	34' @ 50¢		\$17 00			
	Patching		<u>5 00</u>			
			\$22 00			
	Labor					

DATE 2/15/38

TOWN OF LEXINGTON—BOARD OF PUBLIC WORKS
WATER DIVISION

The undersigned applies for a supply of water at No. 1 Candewick Close and hereby agrees to comply with the rules and regulations as now, or at any future time, established by the Board of Selectmen.

Am't. of Estimate \$ _____

Owner Dana T. Lowell


Am't. Paid \$ _____

Address 25 Whiting Rd.

Builder _____

Wellesley Hills

Sketch of Service Here

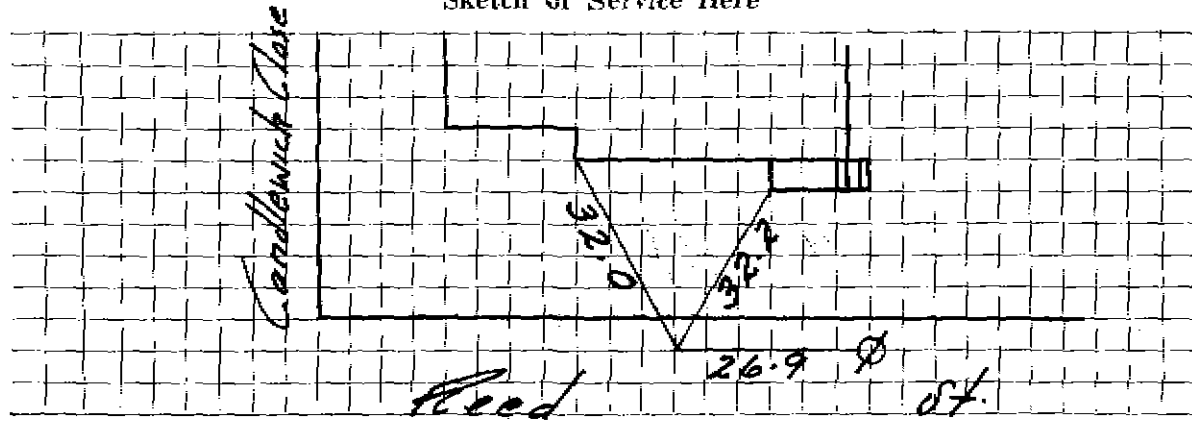

Connection made in _____ Street.

Work completed _____ 19

Remarks: