

Name Dana T. Lowell

Service No. ~~455~~

Address ~~85 Whiting Road, Wellesley Hills, Mass.~~

401

Location 5 Candlewick Close

Kind of Pipe

Size

Size of Main

New Service

~~Repair - Renewal - New Service~~

Location

Date
1938

Material

Amount

Total

Date

Amount

5/12/38

2 hrs. @ 60¢

1 20

1 20

May 3, 1938

Deposited

23 00

41' 3/4" C. Tubing @ 20¢

8 20

1 3/4" S. & S.

3 75

Trucking- 2 hrs @ 75¢

1 50

14 65

Flat Rate:

41' \$23.00

\$23 00

Labor

DATE Feb. 21 1938

TOWN OF LEXINGTON—BOARD OF PUBLIC WORKS

WATER DIVISION

The undersigned applies for a supply of water at No. 5 Sandwick Lane St. and hereby agrees to comply with the rules and regulations as now, or at any future time, established by the Board of Selectmen.

Am't. of Estimate \$ _____

Owner


Dana Lowell
25 Whiting Rd.
Wellesley Hills

Am't. Paid \$ _____

Address

Builder _____

Sketch of Service Here

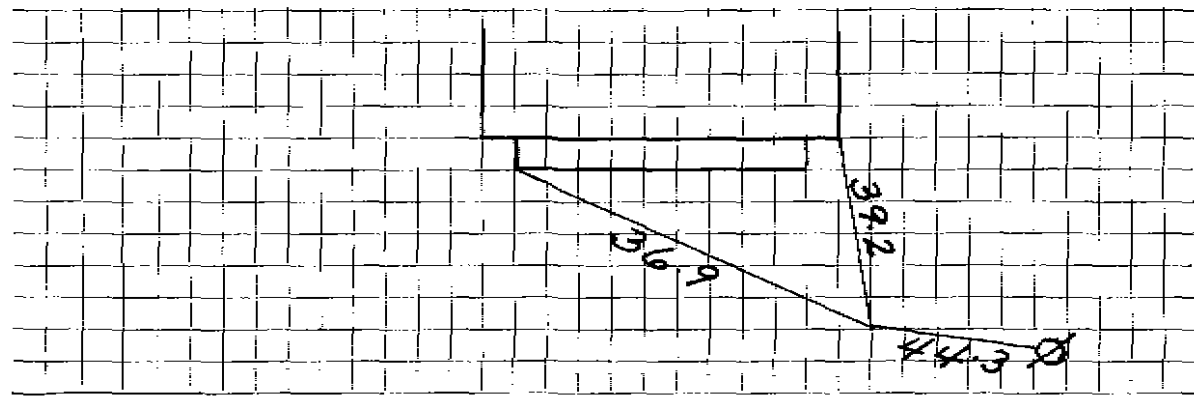

Connection made in _____ Street.

Work completed _____ 19

Remarks: