

WATER SERVICE RECORD

Name *North Shore Development*

Service No.

Address *2 Carl Rd*

Location *Lexington Ma.*

PERMIT NO. 0976-RUGGERI

Repair—Renewal—New Service

New 1" Service 6-20-97


| Date | Material | Amount | Total | Date | Amount |
|----------------|-------------------------|--------|-------|--------------------------|-------------------------|
| <i>3/16/48</i> | <i>Original Service</i> | | | | |
| <i>6/24/97</i> | <i>Renewed to 1"</i> | | | | |
| <i>33'</i> | <i>Copper tubing</i> | | | | |
| <i>1</i> | <i>1" Valve</i> | | | | |
| | | | | <i>Outside - Renewal</i> | |
| | | | | <i>24'</i> | <i>1" Copper tubing</i> |
| | | | | <i>1</i> | <i>1" Corp cock</i> |
| | | | | <i>1</i> | <i>1" Curb cock</i> |

DATE JUNE 19, 1997

TOWN OF LEXINGTON — BOARD OF PUBLIC WORKS

WATER DIVISION

Sketch of Service Here

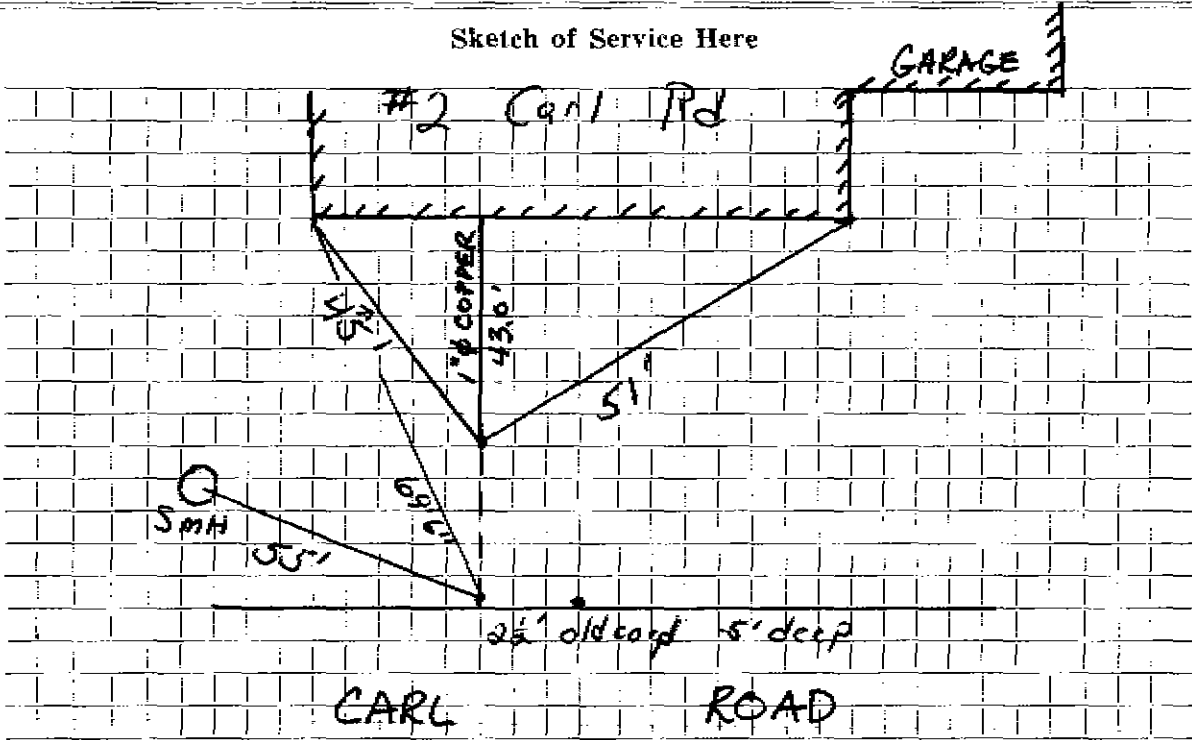

Connection made in Street. Work completed

Remarks: