

Name William E. Selfridge

Service No. #5001

Address 4 Carl Road

Lexington, Mass.

Location 4 Carl Road

Kind of Pipe Com. May 31, 1948

Size

Size of Main

~~Repair or Renewal~~—New Service

Location

Date	Material	Amount	Total	Date	Location	Amount
Mar. 16, '48	Labor	11 37	11 37	Mar. 16, '48	Deposited	35 00
	10% Overhead		1 14	June 3, '48	Deposited	4 17
	33' - 3/4" Copper Tubing @ .255		8 42		Non-Charge	30 83
	1 - 3/4" C x 1/2" I.W.E./ S & W		3 15	Mar. 16, '48	Labor	10 25
	Town Shovel 1 hr. @ 3.00		3 00	24' - 3/4" Copper Tubing @ .255		6 12
	Allis Chalmers 1 hr. @ 3.00		3 00	1 - 3/4" C Corp-cock		3 00
	Trucking 1 hr. @ .75		75	1 - 3/4" C x 3/4" C Curb-cock		3 68
			30 83	1 - Box & Rod		3 50
				Town Shovel 1 hr. @ 3.00		3 00
				Trucking 1 hr. @ .75		75
				1 - 1/2" Offset Tail Piece		30
				1 - 2" Straight Tail Piece		30
	Labor					30 90

TOWN OF LEXINGTON - BOARD OF PUBLIC WORKS

WATER DIVISION

The undersigned applies for a supply of water at No..... St. and hereby agrees to comply with the rules and regulations as now, or at any future time, established by the Board of Selectmen.

Am't of Estimate \$.....


Owner

Am't Paid \$.....

Address

Builder

Sketch of Service Here

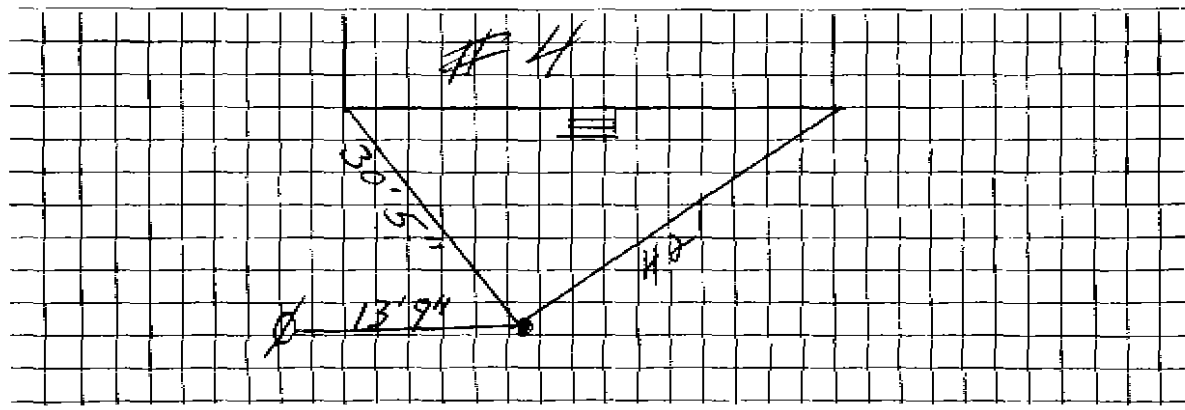

Connection made in Street.

Work completed19

Remarks: