


DATE 10/15/19

TOWN OF LEXINGTON — BOARD OF PUBLIC WORKS

WATER DIVISION

Sketch of Service Here

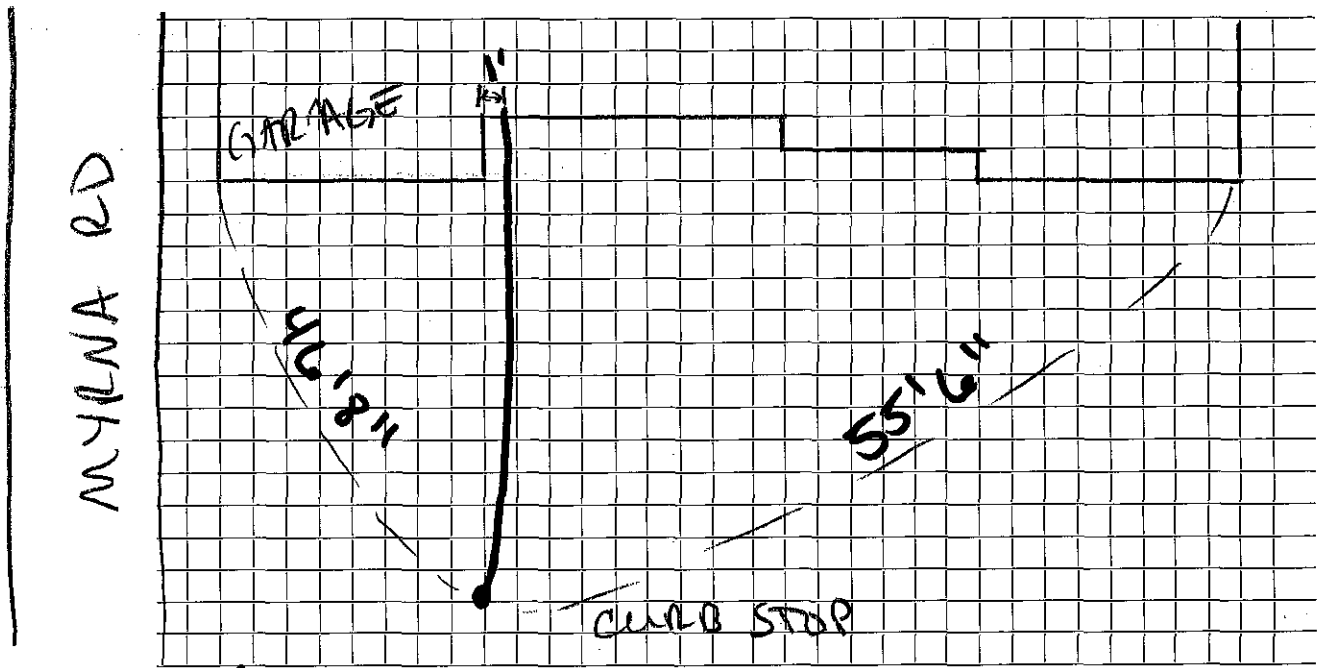

Connection made in Carl Rd ~~Street~~ Work completed

Remarks:

.....

.....