

Name Custance Bros., Inc.  
Address Bedford St., Lexington

Service No. ~~45~~ 457

Location ~~Bed St.~~ *1 Conley St.*

Kind of Pipe      Size      Size of Main

~~Repair~~ ~~Renewal~~ - New Service

Location

Date	Material	Amount	Total	Date	Amount
<i>Jan. 27 - 1-20-34</i>	60' 1" Copper Pipe @.19	\$11 40			
	1 S & W	2 75			
	1 1" Bend	1 10	\$15 25		
	3 Hrs. Labor @.55	1 65			
	2 " " @.80	1 20	2 85		
	10% Overhead		23		
			\$18 38		
	60 ft. @ .45	\$27 00	\$27 00	<i>May 3, 1934 - Cash -</i>	27 00
	<b>Labor</b>				

Hadley Press, Inc., Lexington

# TOWN OF LEXINGTON—BOARD OF PUBLIC WORKS

## WATER DIVISION

The undersigned applies for a supply of water at No. \_\_\_\_\_ St. and hereby agrees to comply with the rules and regulations as now, or at any future time, established by the Board of Selectmen.


Am't. of Estimate \$ \_\_\_\_\_

Owner \_\_\_\_\_

Am't. Paid \$ \_\_\_\_\_

Address \_\_\_\_\_

Builder \_\_\_\_\_

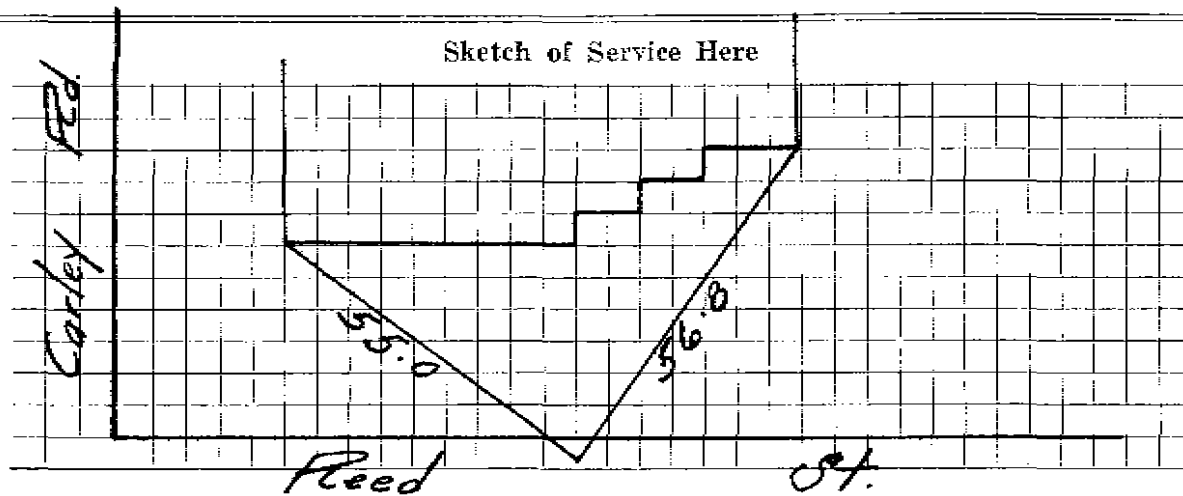

Connection made in \_\_\_\_\_ Street.

Work completed \_\_\_\_\_ 19

Remarks: