

Name George Selfridge

Service No. 46

#5107

Address 10 Carley Road

Lexington, Mass.

Location 10 Carley Road

Kind of Pipe

Size

Size of Main

Repair ~~Revised~~ New Service

Com. 8023-48

Location

Date	Material	Amount	Total	Date	Amount
Jul. 14, '48	Labor	1 15	1 15	May 22 '48	45 00
	10% Overhead		12	Aug 20 '48	29 33
	36' - 3/4" Copper Tubing @.255	9 18	9 18	<i>Expended</i> Non-Charge	
	1 - 3/4" C x 1/2" I.W.H. S & W	3 15	3 15		
	1 - 3/4" C x 3/4" C Union (3pts)	1 32	1 32	Jul. 14, '48	1 15
	Trucking 1 hr. @.75		75	16' - 3/4" Copper Tubing @.255	4 08
			15 67	1 - 3/4" C Corp-cock	3 00
				1 - 3/4" C x 3/4" C Curb-cock	3 68
				1 - Box & Rod	3 55
				1 - 1/2" Straight Tail Piece	30
				1 - 1/2" Offset Tail Piece	30
				Trucking 1 hr. @.75	75
					16 81
	Labor				

Hadley Press, Inc., Lexington

DATE \_\_\_\_\_

# TOWN OF LEXINGTON—BOARD OF PUBLIC WORKS

## WATER DIVISION

The undersigned applies for a supply of water at No. \_\_\_\_\_ St. and hereby agrees to comply with the rules and regulations as now, or at any future time, established by the Board of Selectmen.

Am't. of Estimate \$ \_\_\_\_\_


Owner \_\_\_\_\_

Am't. Paid \$ \_\_\_\_\_

Address \_\_\_\_\_

Builder \_\_\_\_\_

Sketch of Service Here

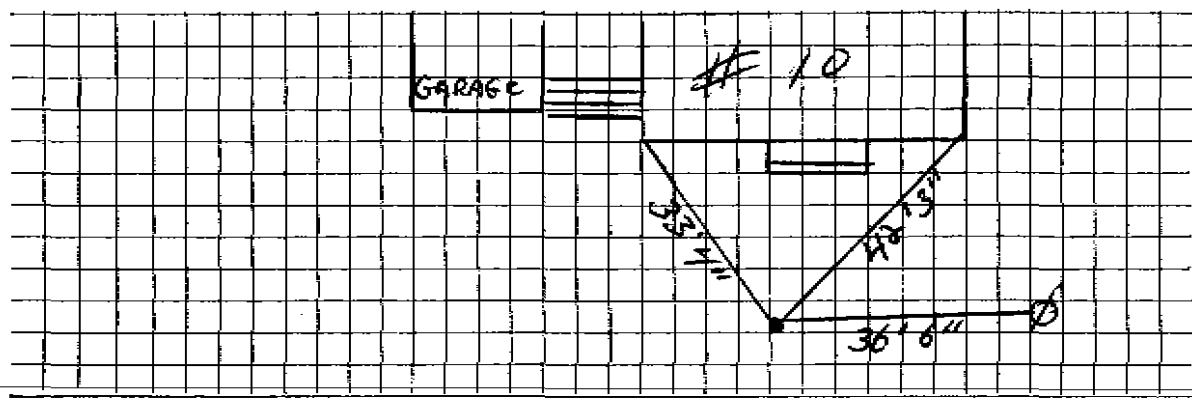

Connection made in \_\_\_\_\_ Street.

Work completed \_\_\_\_\_ 19

Remarks: