


DATE 8/12/19

TOWN OF LEXINGTON — BOARD OF PUBLIC WORKS
WATER DIVISION

Sketch of Service Here

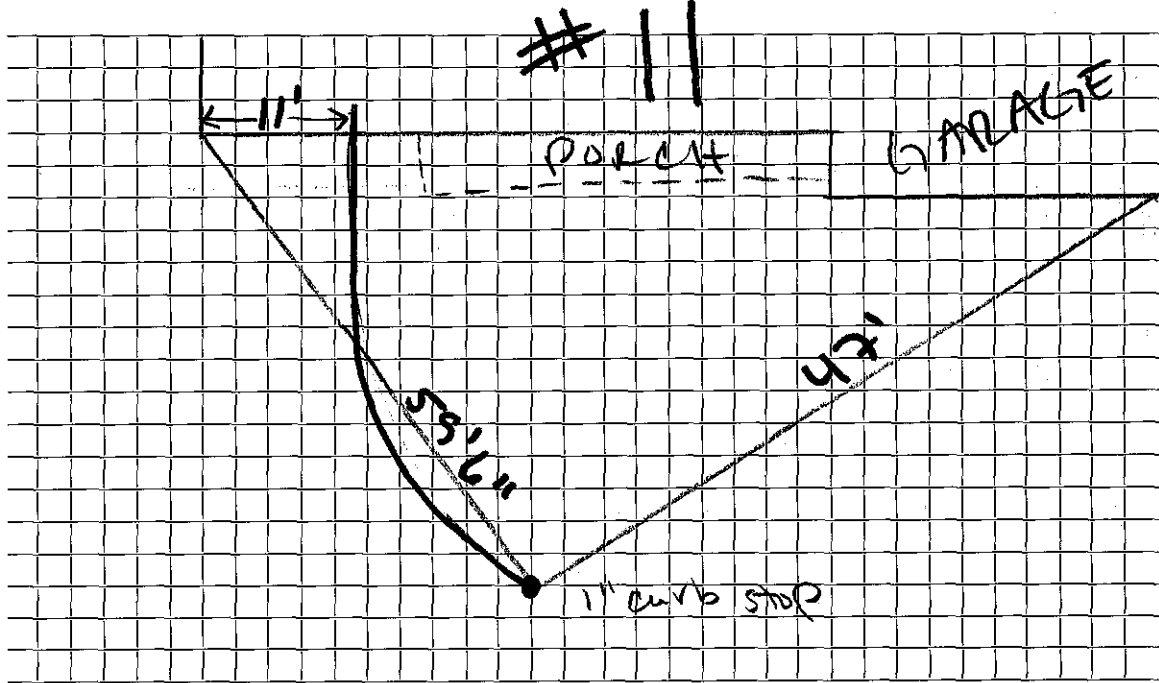

Connection made in Cartney Rd Street: Work completed

Remarks: