

Name George Selfridge

1245

Service No.

83

Address 12 Carley Road
Lexington, Mass.

Location 12 Carley Road

Kind of Pipe

Size

Size of Main

~~Repair-Renewal~~ - New Service

Location

Date	Material	Amount	Total	Date	Amount
Jul. 14, '48	Labor	1 15	1 15	June 27 '48	15 00
	10' Overhead		12		
	35' - 3/4" Copper Tubing @ .255	9 18			
	1 - 3/4" C x 3/4" I.W.K. S&W	3 15		Jul. 14, '48	1 15
	Trucking 1 hr. @ .75		75		
			14 35	22' - 3/4" Copper Tubing @ .255	5 61
				1 - 3/4" C Curb-cock	3 00
				1 - 3/4" C x 3/4" C Curb-cock	3 68
				1 - Box & Rod	3 55
				1 - 1/2" Offset Tail Piece	30
				1 - 1/2" Straight Tail Piece	30
				Trucking 1 hr. @ .75	75
					18 34
	Labor				

Deposited

Non-Charge

TOWN OF LEXINGTON - BOARD OF PUBLIC WORKS

WATER DIVISION

The undersigned applies for a supply of water at No..... St. and hereby agrees to comply with the rules and regulations as now, or at any future time, established by the Board of Selectmen.

Am't of Estimate \$.....


Owner

Am't Paid \$.....

Address

Builder

Sketch of Service Here

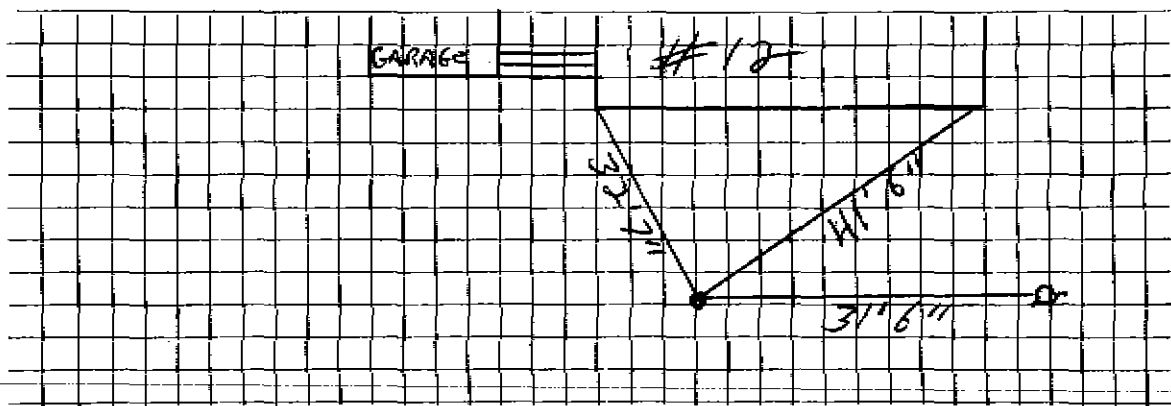

Connection made in Street.

Work completed19

Remarks: