

WATER SERVICE RECORD

Name A. J. Comeau

Service No. 180

Address 17 Carley Road

# 1611

Location Lexington

~~Repair~~ ~~Renewal~~ New Service

*C*  
*com. 9-22-52*


Date	Material	Amount	Total	Date	Amount
8/27/52	Labor	1 63		8-19-52	Deposited 60 00
	10% overhead	16	1 79	9-22-52	Refunded (29 23)
	64' - 3/4" copper tubing@.3439		22 01		<u>NON CHARGE</u> 30 27
	1 - 3/4" Cx 1/2 I.W.H. stop&waste		4 00	8/27/52	Labor 1 63
	1 - 3/4" Cx 3/4" C. union 3 pts.		1 72		24' - 3/4" copper tubing@.3439 8 25
	1 hr. trucking		75		1 - 3/4" C. corp-cock 4 33
			30 27		1 - 3/4" Cx 1/4" C. curb-cock 4 67
					1 - box and rod 3 90
					1 - 1/2 offset tail pc. 50
					1 - 1/2 straight tail pc. 50
					1 hr. trucking 75
					<u>24 53</u>

DATE \_\_\_\_\_

TOWN OF LEXINGTON — BOARD OF PUBLIC WORKS

**WATER DIVISION**

Sketch of Service Here

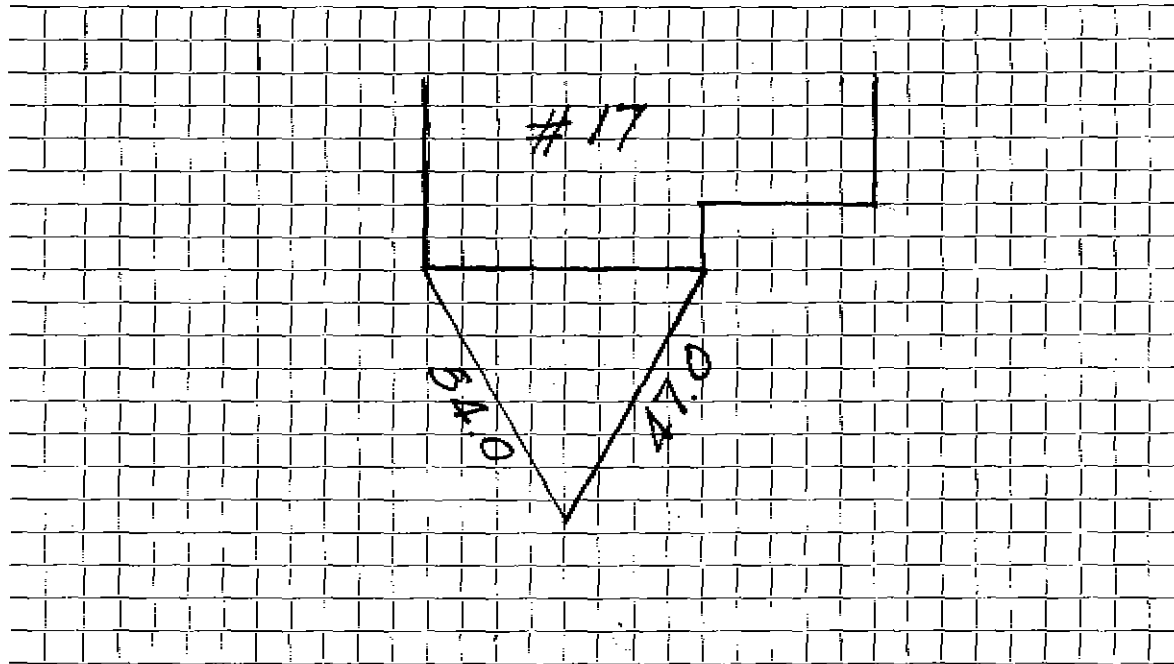

Connection made in ..... Street, ..... Work completed .....

Remarks: .....

.....

.....