


DATE 7/20/17

TOWN OF LEXINGTON — BOARD OF PUBLIC WORKS

WATER DIVISION

Sketch of Service Here

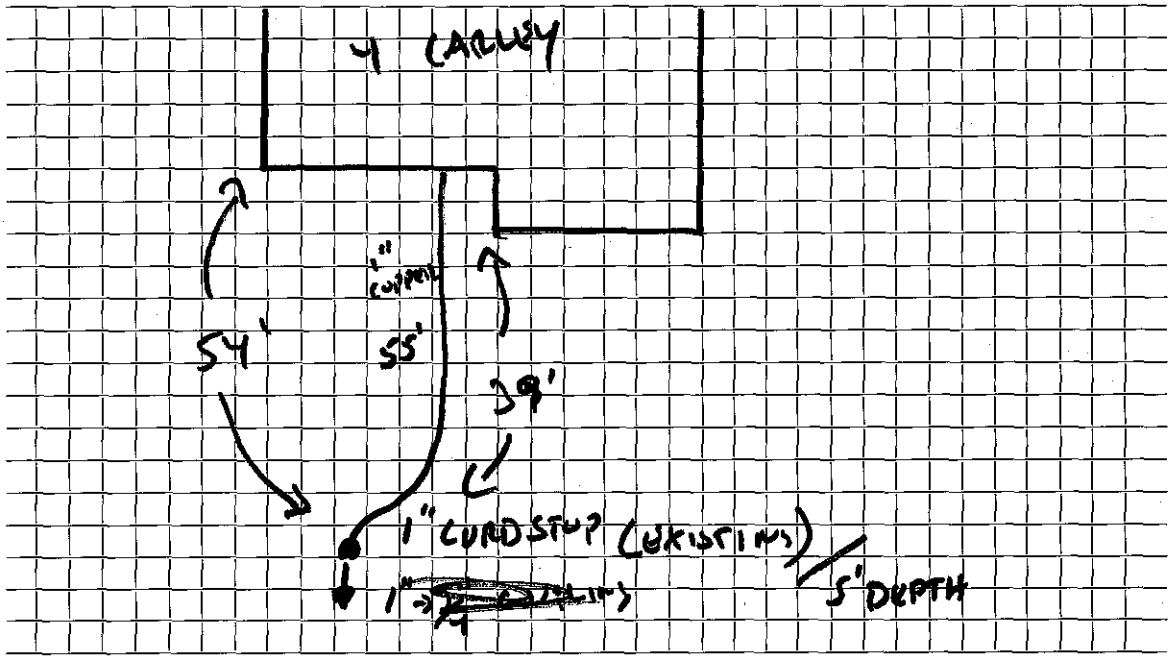

Connection made in CARLEY Street. Work completed ... McLAUGHLIN

Remarks: ~~2-1-17~~