

Water Service Record

Name

Service No.

Address 6 CARLEY RD

Location LEXINGTON, MA


Repair Renewal - New Service

Date	Material	Amount	Total	Date		Amount
5/23/22	1" TYPE K COPPER					
	1" CURB STOP					
	OPEN - RIGHT					
	3/4" to 1" COUPLING					

Date: 5/23/22

TOWN OF LEXINGTON - BOARD OF PUBLIC WORKS
WATER DIVISION

SKETCH OF SERVICE HERE

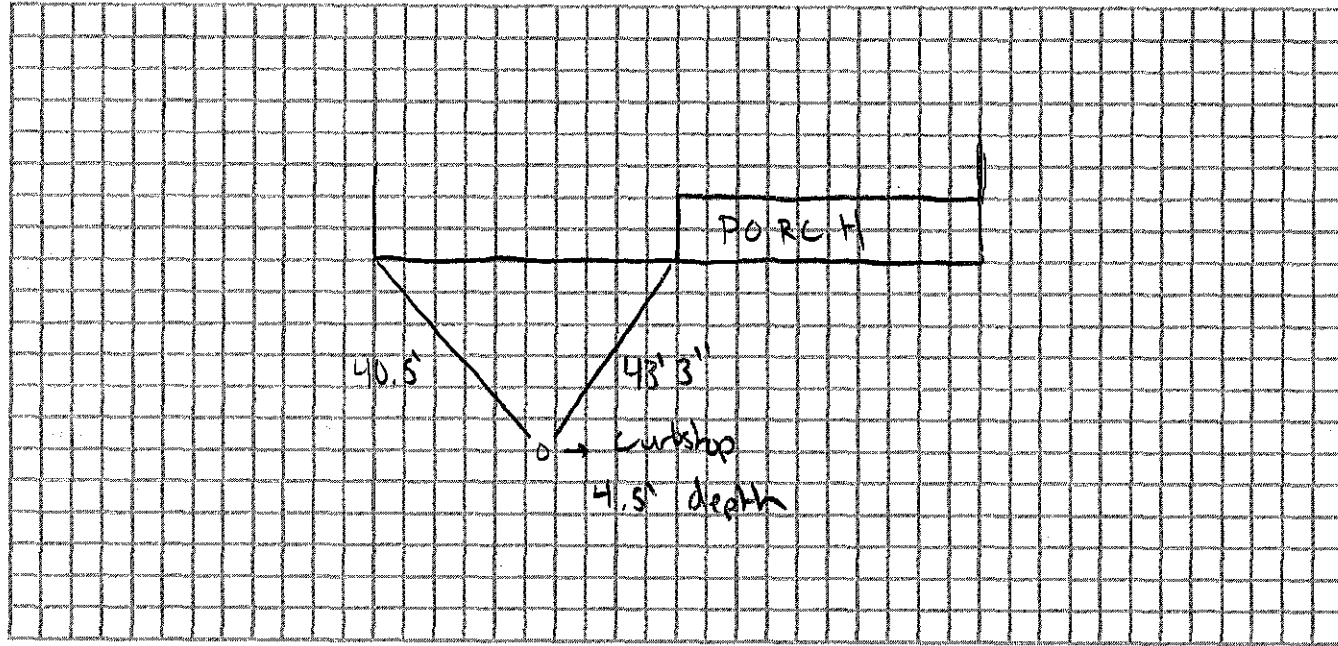

Connection made in: CARLEY RD

Street.

Work completed:

Remarks: INSTALLED BY VINNY MOFFORD EXCAVATION