Æ	æ	, н	+1	ю.)L

WATER SERVICE RECORD


1428

Service No. Name Deck House (28 Monument Ave., Concord) Address 10 Carmel Circle Location Repair-Renewal-New Service Lucente #1508 Material Total Date Amount Date Amount 11-21-69 67 3/4" Copper tubing

TOWN OF LEXINGTON - BOARD OF PUBLIC WORKS

WATER DIVISION

Sketch of Service Here

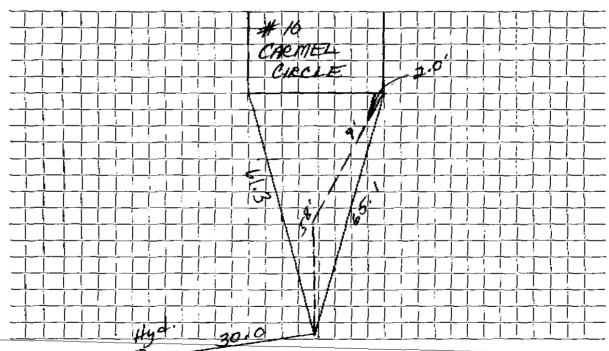

Connecti	ian ma	do in
Connecti	ion ma	uie in

..... Street.

Work completed

Remarks:	 	*******	 	• • • • • • • • • • • • • • • • • • • •	 	
	 		 		 .,	