


DATE _____

TOWN OF LEXINGTON -- BOARD OF PUBLIC WORKS

WATER DIVISION

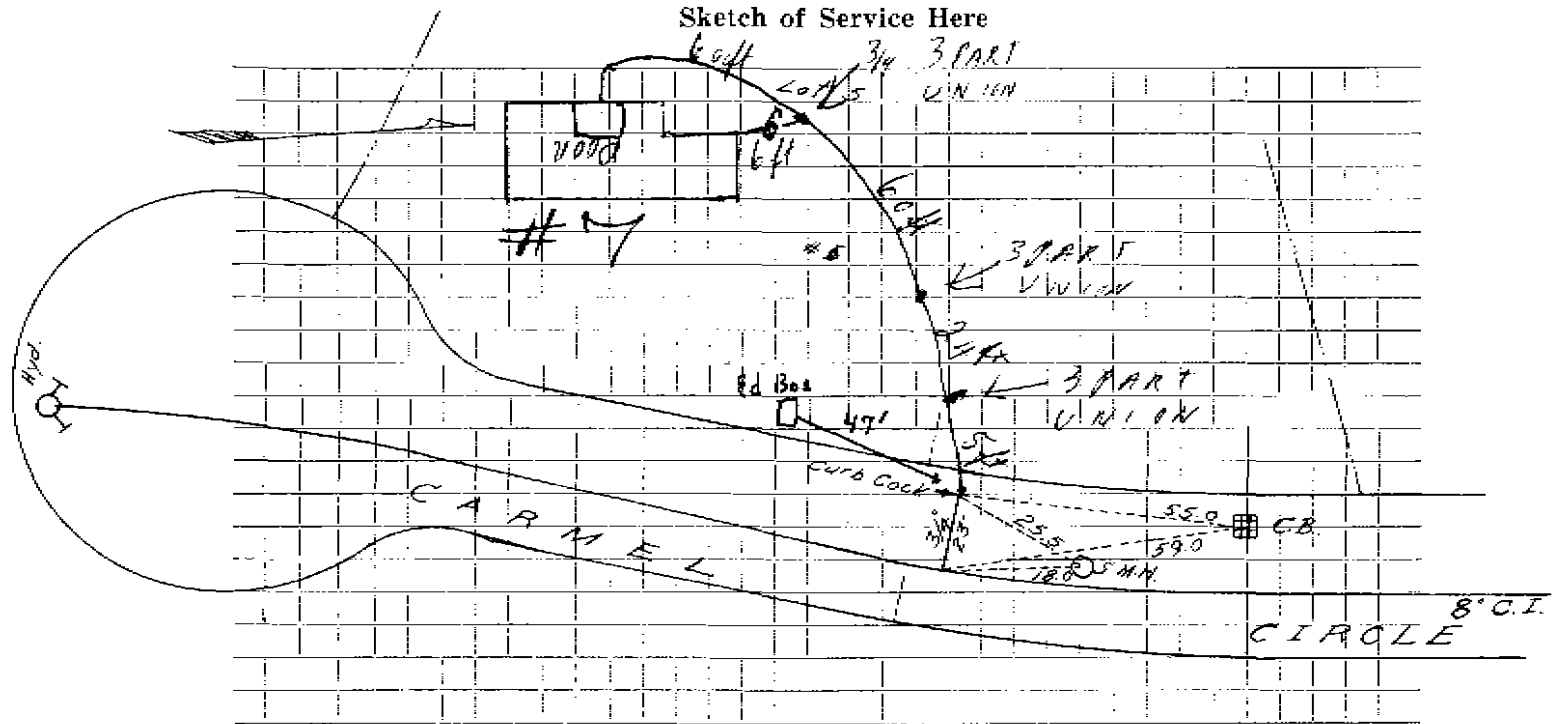

Connection made in Street. Work completed


Remarks:

.....

.....

TOWN OF LEXINGTON — BOARD OF PUBLIC WORKS

WATER DIVISION

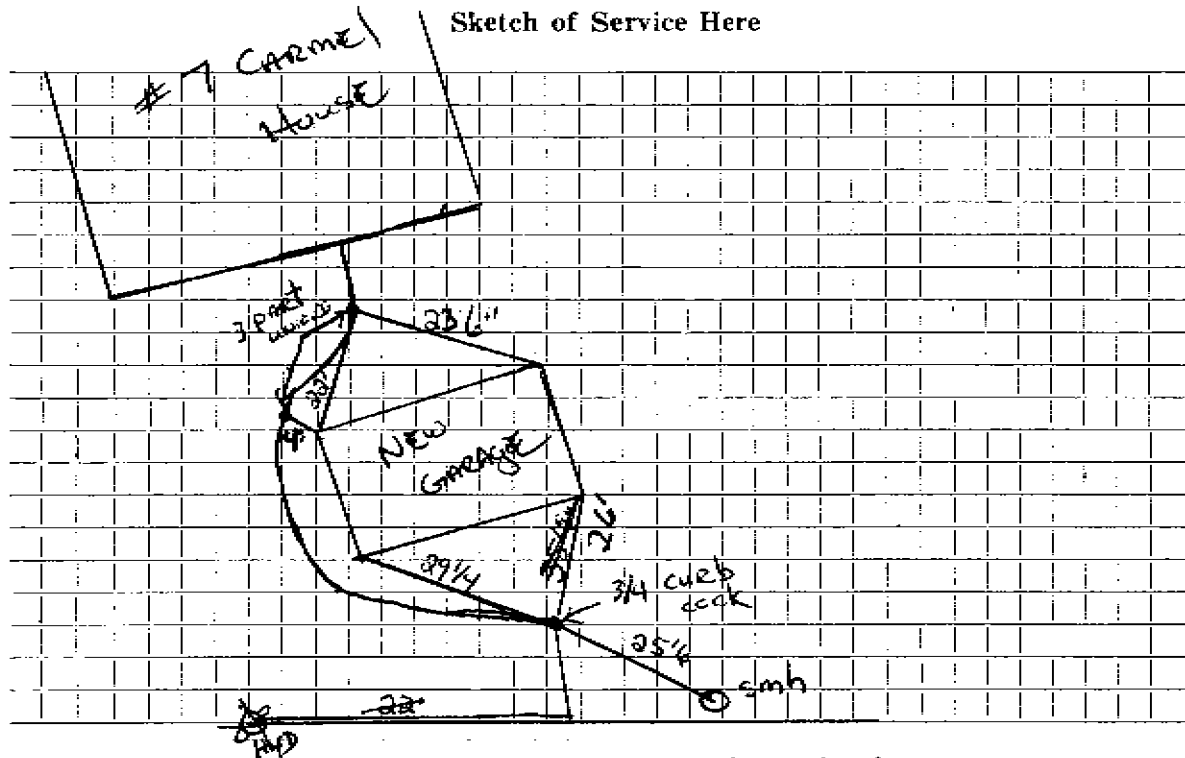

Connection made in Street. Work completed

Remarks: ... WATER SERVICE RELOCATED FOR GARAGE BUILT IN 1985