

WATER SERVICE RECORD

Name John Repetto

Service No. 24

Address 3 Carnegie Place

Location

~~Repair - Renewal~~ New Service W.O. 5706

DEC 12 1977

Date	Material	Amount	Total	Date	Amount
9/15/77	Labor	34 72		8-12-77	150 00
	10% O.H.	3 47	38 19	12-12-77	7 57
31'	3/4 Copper @ .83		25 73		112 43
1	3/4 Corporation		10 53		
1	3/4 Curb		15 07		
1	Box & Rod		13 41		
1	Hr. Trucking		3 00		
1	Hr. Town Shovel		6 50		
			112 43		


9/16/77 52' 3/4" COPPER

* Applied to WHO # 67

DATE _____

TOWN OF LEXINGTON — BOARD OF PUBLIC WORKS
WATER DIVISION

Sketch of Service Here

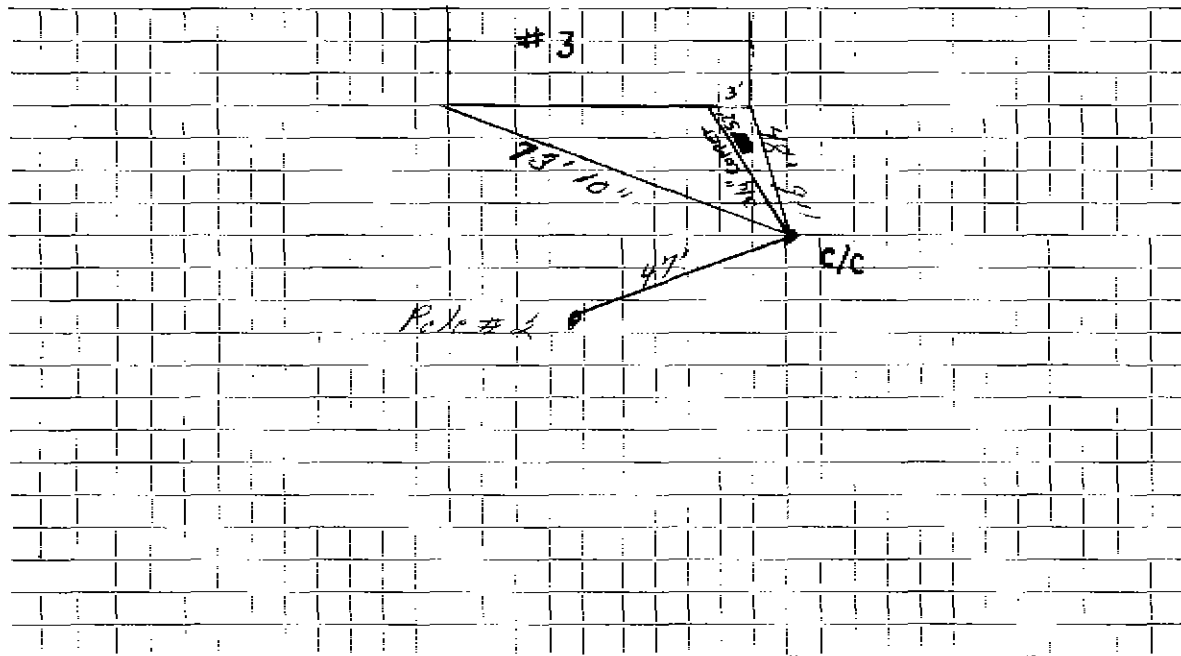

Connection made in _____ Street. Work completed _____

Remarks: 2: 3/4 Comp. union Installed on 10-5-91 also 7' of 3/4 Copper.

