


TOWN OF LEXINGTON — BOARD OF PUBLIC WORKS

WATER DIVISION

DATE _____

Sketch of Service Here

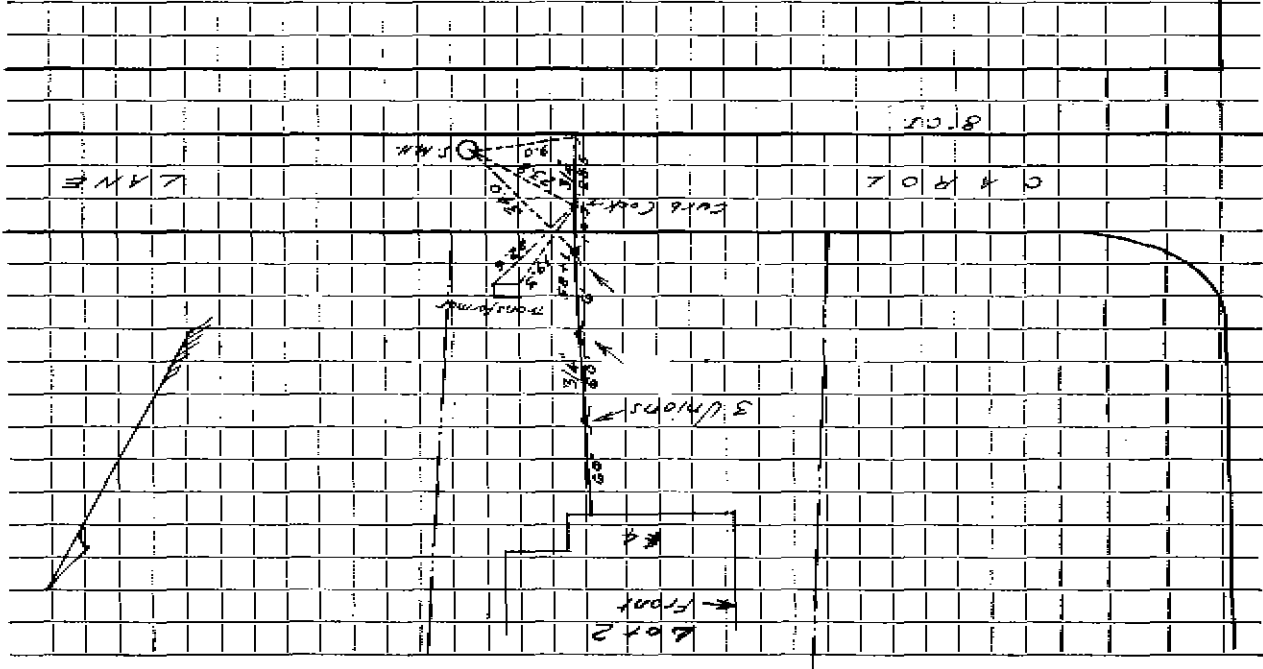

BEDFORD ST
P. 61

Connection made in _____ Street. Work completed _____

Remarks: _____