


TOWN OF LEXINGTON — BOARD OF PUBLIC WORKS

WATER DIVISION

DATE _____

Sketch of Service Here

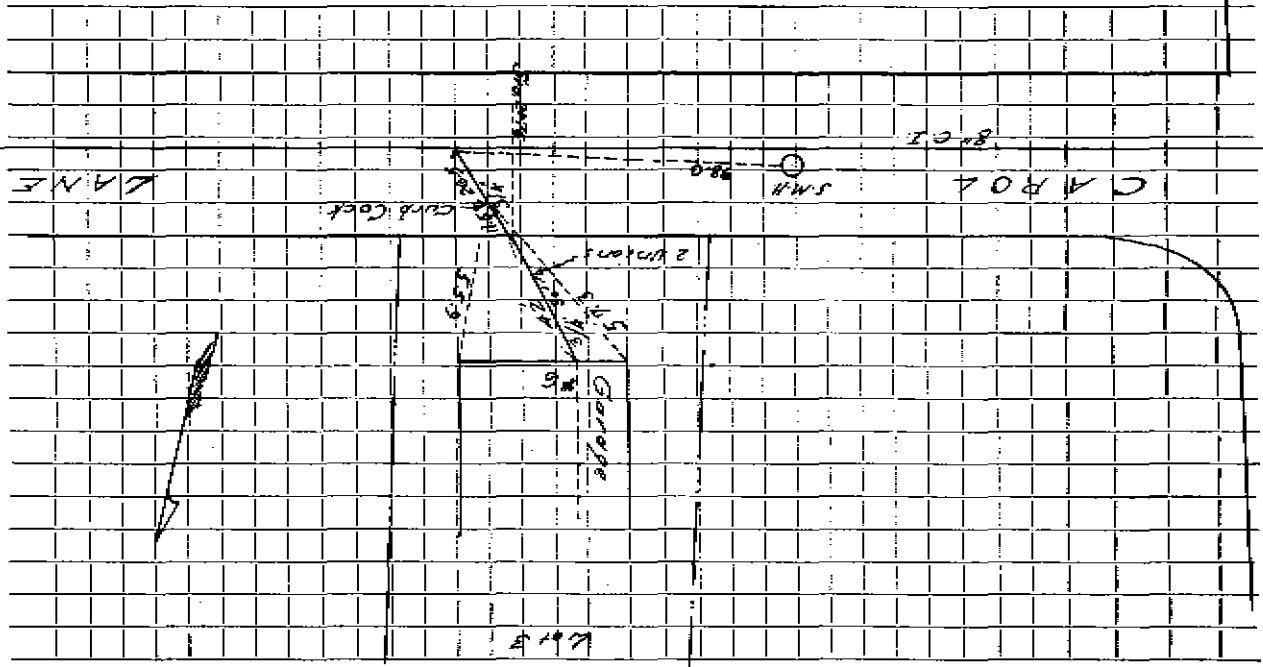

Street. Work completed

Connection made in

Remarks:

B E D F O R D
18" C.I.
SM