




DATE 2/19/2021

TOWN OF LEXINGTON — BOARD OF PUBLIC WORKS

WATER DIVISION

Sketch of Service Here #10

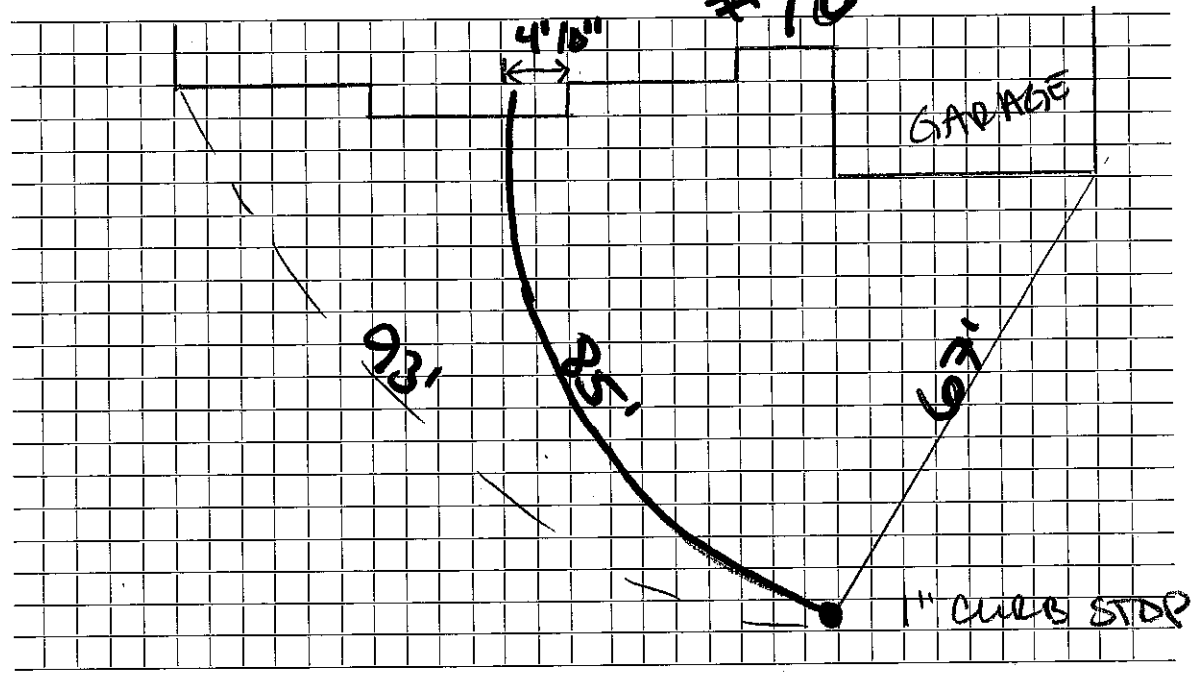

Connection made in Carriage Drive Street. Work completed .....

Remarks: pipe insulated @ depths of 4'