




TOWN OF LEXINGTON -- BOARD OF PUBLIC WORKS

WATER DIVISION

Sketch of Service Here

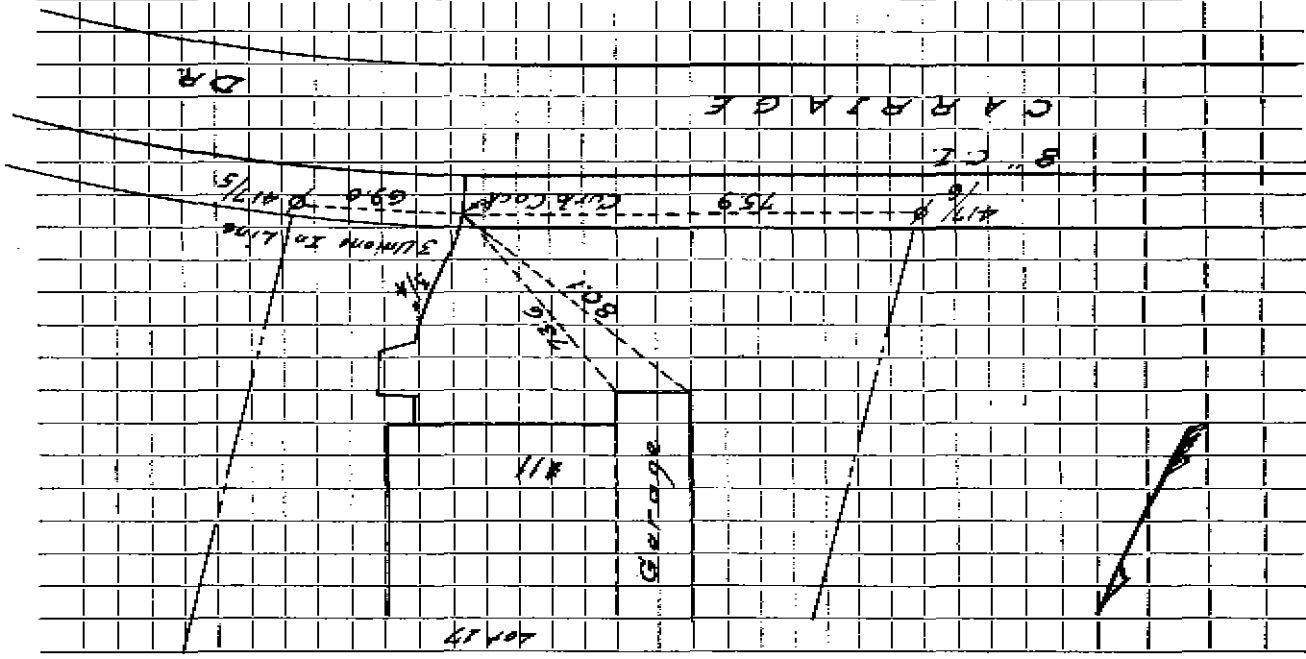

Street. Work completed

Connection made in

Remarks: