WATER SERVICE RECORD


Name Alfred Camarano		 	Service No.				
Addr	ess	17 Carriage Drive					
Loca	tion	Lot #19					
 			Permit #290 Ferrari Permit #168		AUG 9 1965		
Date		Material	Material Amount		Date	Amount	
8/3/65	201	3/4" Copper tubing					
6/66	1	3/h" Copper					
		V V V V V V V V V V V V V V V V V V V					
		į					
·	 				#		
	}	}					
	 			-	 		
	 -	 		-			
	 -		 		<u> </u>		
	 -				 		
	╁						
	 	•					
	 				 		
	 -			·			
					 		
	 -	_					
	 		! 	- 	#		
	<u> </u>	[
	 	 	 				
	ŧ.			ir. 4	ff l		

_	•	_	-	
	-	7	_	

TOWN OF LEXINGTON - BOARD OF PUBLIC WORKS

WATER DIVISION

Sketch of Service Here

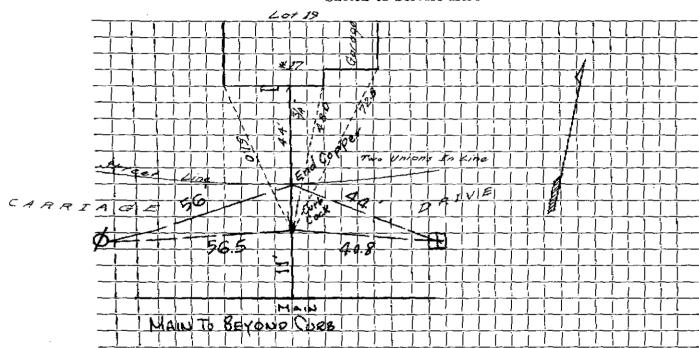

Connection made in	Work completed
Remarks:	
