

DATE _____


TOWN OF LEXINGTON — BOARD OF PUBLIC WORKS

WATER DIVISION

Lot #8

CARRIAGE DR.

Sketch of Service Here

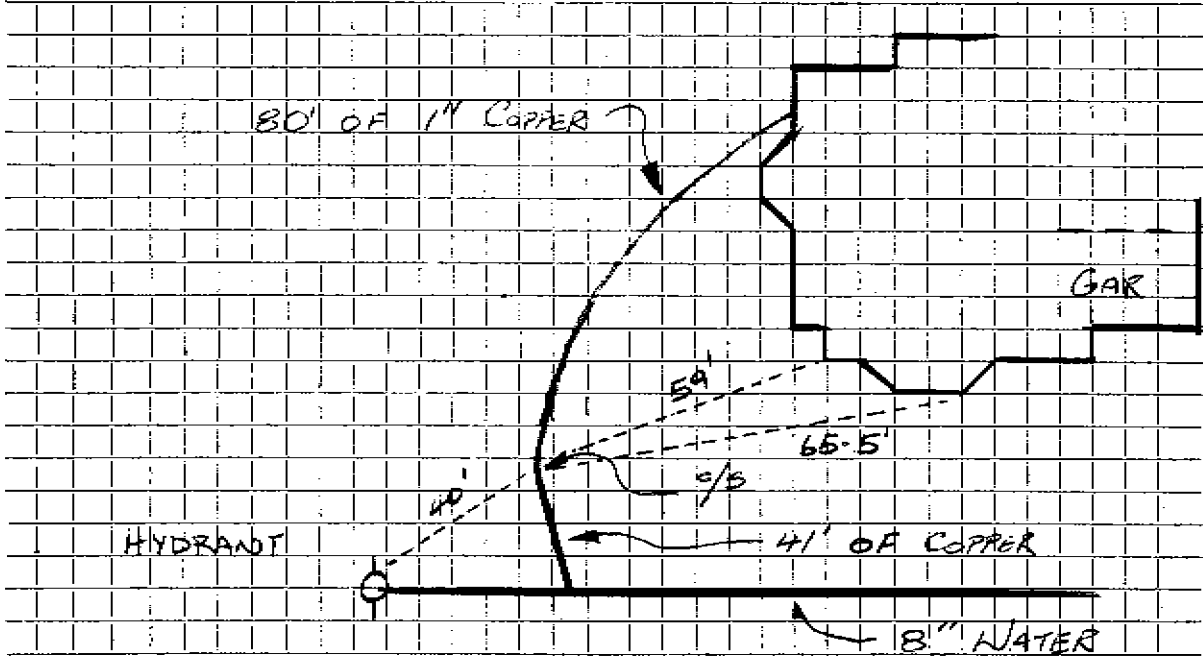

Connection made in Street. Work completed

Remarks: .. COMBINED .. LOTS .. 8 & 9 .. INTO .. ONE .. LOT .. & .. USED .. LOT .. #9 .. WATER .. SERVICE ..
 .. CONTRACTOR .. S. J. McLEODGALIN ..