


DATE _____

TOWN OF LEXINGTON — BOARD OF PUBLIC WORKS

WATER DIVISION

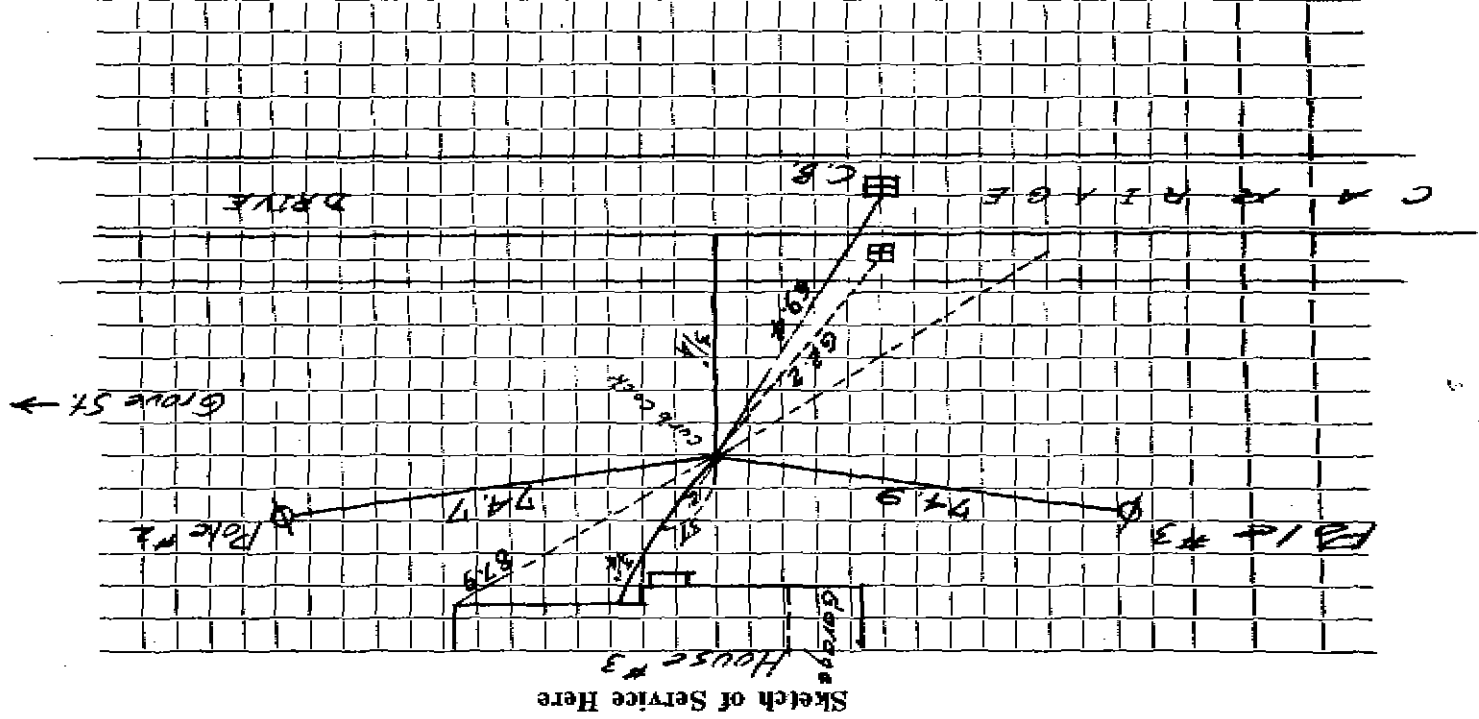

Street: _____
Work completed _____

Connection made in _____

Remarks: _____

