

5469

WATER SERVICE RECORD

Name Pelham Const. Co.

Service No.

Address 4 Carriage Drive

Location Lot 1 Sta. 3+05

DeFelice # 1923

~~Revision Report~~ - New Service

SERVICE BY BUILDER


Date	Material	Amount	Total	Date	Amount
	13' 3/4" Copper tubing				
10/19/71	78' 3/4" Copper tubing				
				23' 3/4" Copper tubing	
				1 Corp Cock	
				1 Curb Cock	
				1 Box & Rod	

DATE _____

TOWN OF LEXINGTON — BOARD OF PUBLIC WORKS

WATER DIVISION

Sketch of Service Here

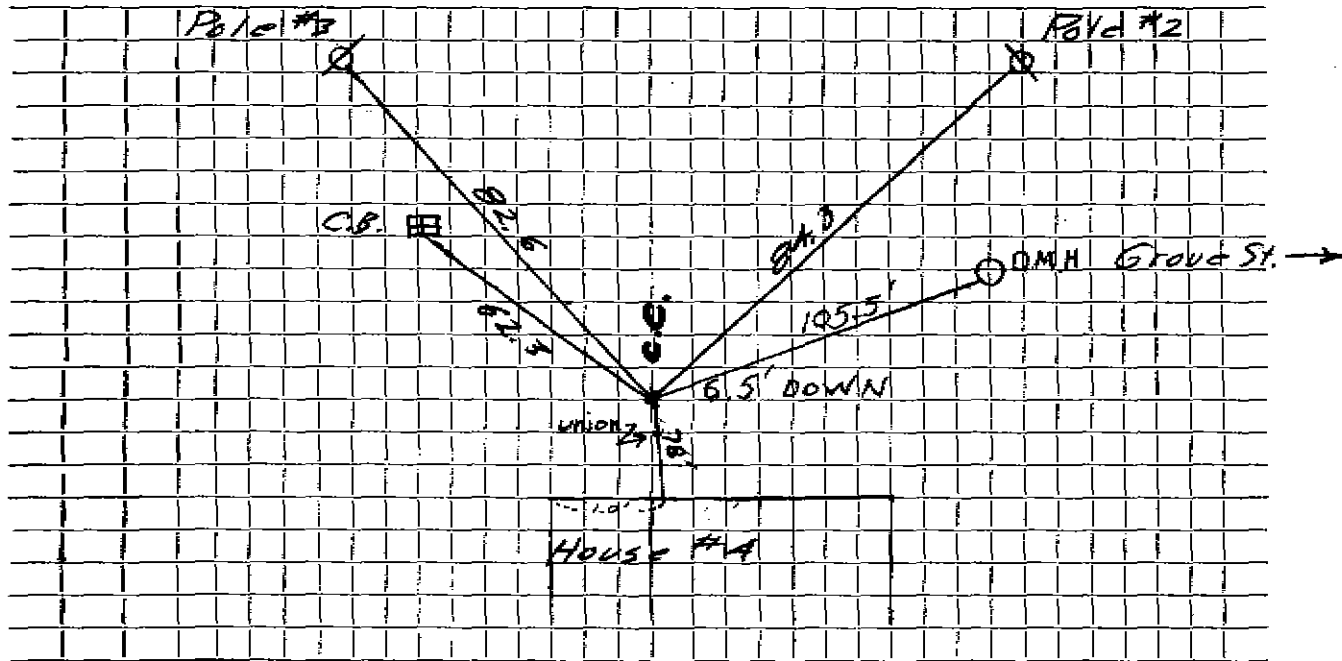

Connection made in Street. Work completed

Remarks:
.....
.....