

WATER SERVICE RECORD

Name Pelham Const.

Service No.

Address 7 Carriage Drive

Location Lot 15 Sta. 4+57

Repair ~~Reserve~~ New Service Kingston #1766  
~~XXXXXXXXXX~~ SERVICE BY BUILDER DeFlice #1267


Date	Material	Amount	Total	Date	Amount
	10' 3/4" Copper tubing				
11-26-68	78' 3/4" Copper tubing				
11-6-70	47' 3/4" Copper tubing				
				10' 3/4" Copper tubing	
				1 Corp Cock	
				1 Curb Cock	
				1 Box & Rod	

DATE \_\_\_\_\_

TOWN OF LEXINGTON — BOARD OF PUBLIC WORKS

WATER DIVISION

Sketch of Service Here

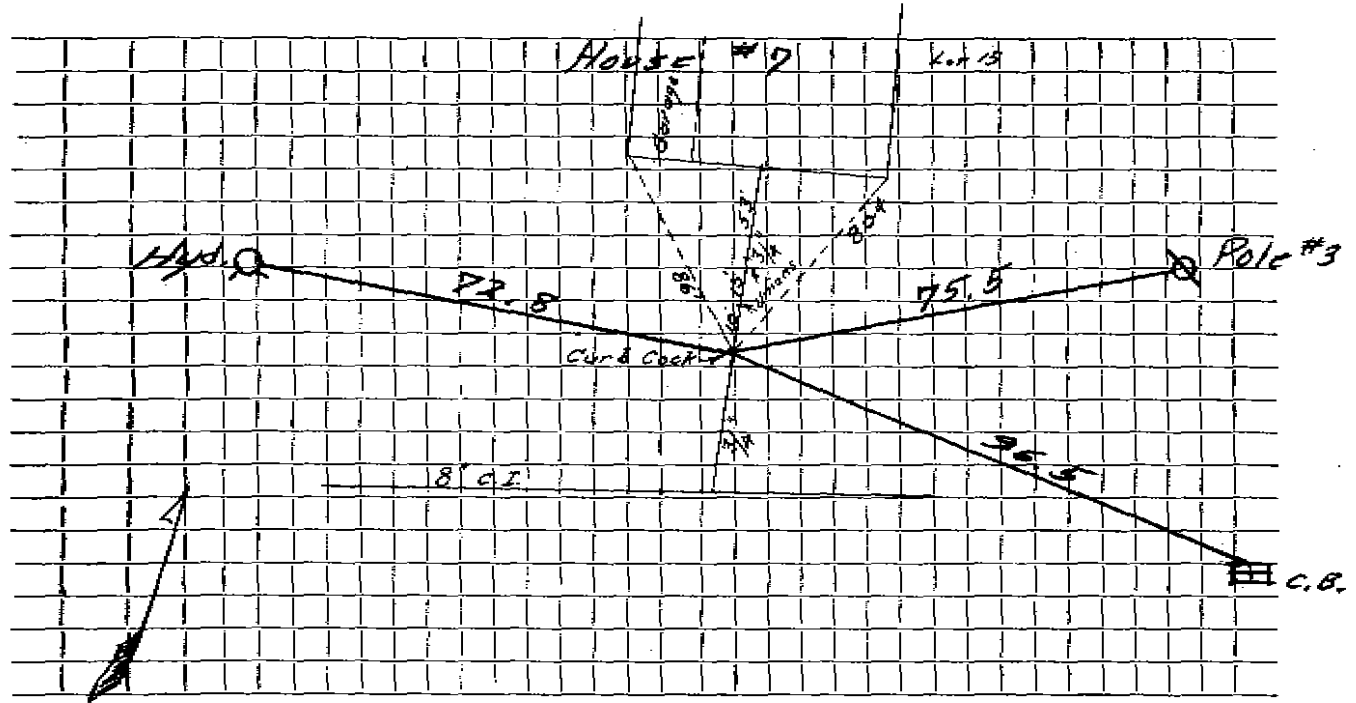

Connection made in ..... Street. Work completed .....

Remarks: .....  
.....  
.....