

WATER SERVICE RECORD

Name *Carriage Homes Inc.*

Service No.

Address " *9 Carriage Dr. Va.*

Location *2nd St*

Repair—Renewal—New Service


Date		Material	Amount	Total	Date		Material	Amount
<i>12/22/65</i>		<i>10'</i>	<i>3/4 COPPER</i>			<i>13'</i>	<i>3/4 COPPER</i>	
		<i>66'</i>	<i>3/4 COPPER</i>			<i>1</i>	<i>CORP</i>	
		<i>2</i>	<i>3/4 UNIONS</i>			<i>1</i>	<i>3/4 CURB STOP</i>	
							<i>BOX &amp; ROD</i>	

DATE \_\_\_\_\_

TOWN OF LEXINGTON — BOARD OF PUBLIC WORKS

WATER DIVISION

Sketch of Service Here

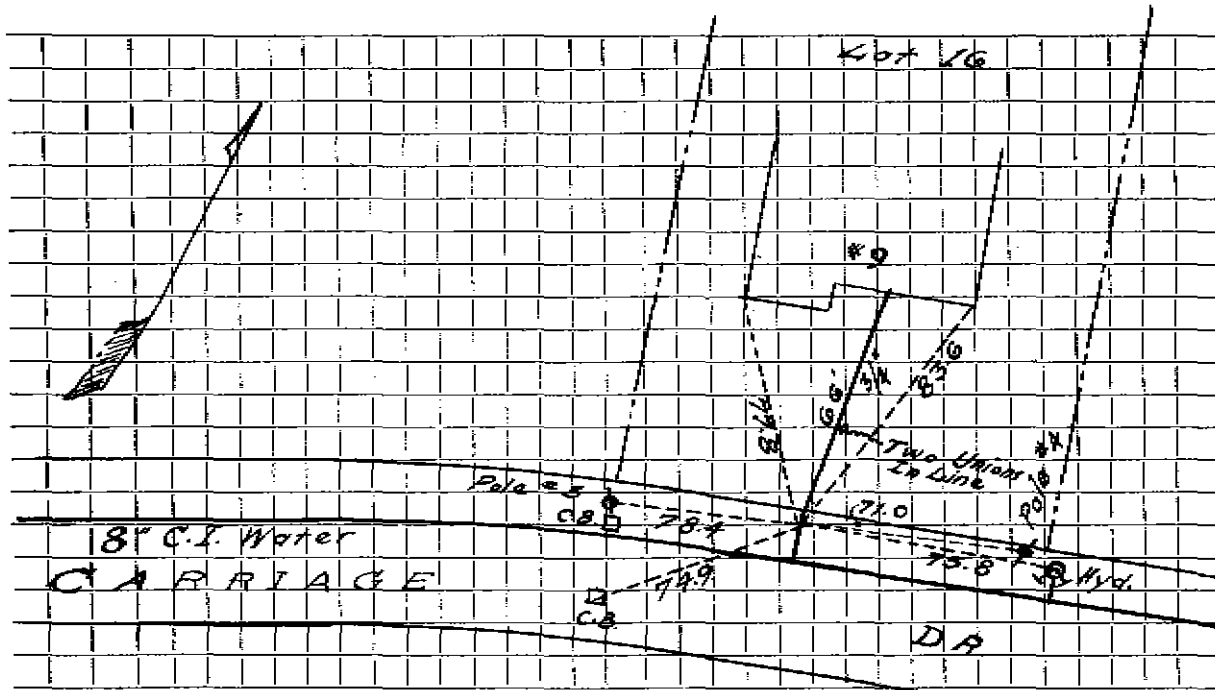

Connection made in ..... Street. Work completed .....

Remarks: .....  
.....  
.....