Service No.

그러워 가는 사람들이 하는 것이다.	**	1
	•	'
Name	*	
wame	•	

Address 13 CART PATH LANG


Location LEXINGTIN. MA

Repair - Renewal - New Service								
Date	Material	Amount	Total	Date		Amount		
9/8/22	1" Type k Copper							
	1" CURB STOP							
	Open - RIGHT							
		-						
Manual Art	BUFFALO BOX							
No.				·				
	<u> </u>				14			
		·						

Date: 4/8/22

TOWN OF LEXINGTON - BOARD OF PUBLIC WORKS WATER DIVISON

SKETCH OF SERVICE HERE

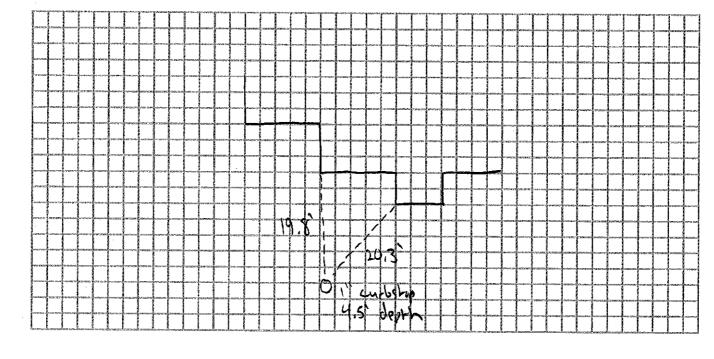

Connection made in:	Matagram (1911)		Street.	Work completed:
Remarks: TNSTALLES	ßy\	VANARIA 6	Sors	
• 				от при при при при при при при на при на при на при на при на при
анузыськи меня желусту е фимпиянний призуровает приметаний пискин	ы папана изинана изина	:442824()रः (१९) १५० (१४) सम्बन्धाः सम्बन्धाः सम्बन्धाः सम्बन्धाः सम्बन्धाः सम्बन्धाः सम्बन्धाः सम्बन्धाः सम्ब	ierbing rock (dien in dien in komponium in die de (dien in men in	