




DATE 1/11/19

TOWN OF LEXINGTON — BOARD OF PUBLIC WORKS

WATER DIVISION

Sketch of Service Here

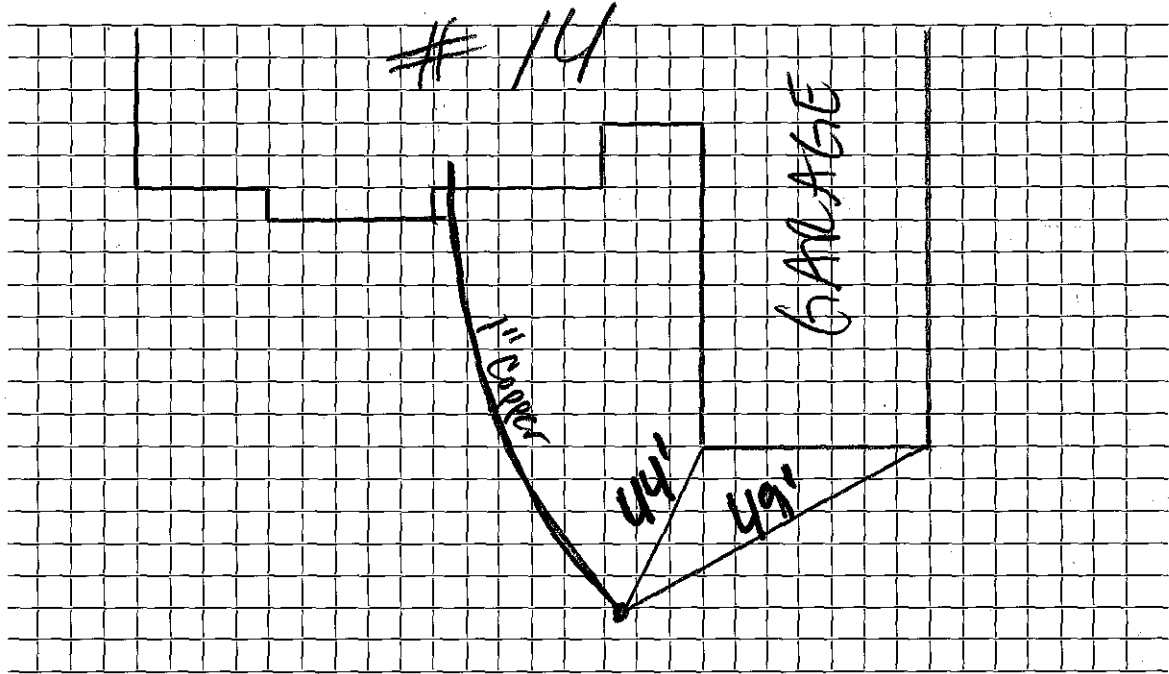

Connection made in... Cart Path Ln Street.

Work completed .....

Remarks: .....

.....

.....