

WATER SERVICE RECORD

Name *Marissa Liggiero (Insp.)*

Service No.

Address *15 Cart Path Ln*

Location

Contractor: *Iovino*

Repair—Renewal—New Service


Date	Material	Amount	Total	Date	Amount
<i>9/29/19</i>	<i>CURB to HOME</i>				
	<i>1" Curb stop</i>				
	<i>7' 1" Copper</i>				
	<i>1" Union</i>				
	<i>60' 1" Copper</i>				
	<i>67' Total length</i>				
	<i>of Copper</i>				
	<i>type K</i>				
	<i>comb. brass</i>				
	<i>open right</i>				

DATE 8/29/2018

TOWN OF LEXINGTON — BOARD OF PUBLIC WORKS
WATER DIVISION

Sketch of Service Here

#15

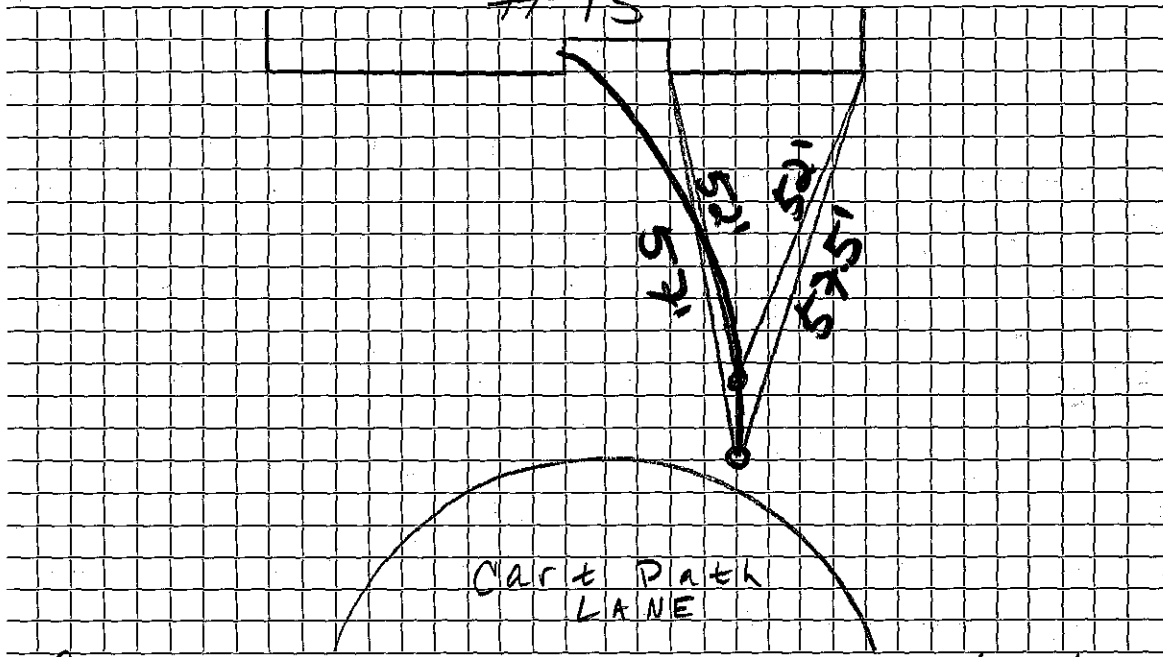

CART PATH
LANE

Connection made in Cart Path Ln Street. Work completed 8/29/18 2:30PM

Remarks:

o = Curb Stop
• = Union