




DATE 9/5/2018

TOWN OF LEXINGTON — BOARD OF PUBLIC WORKS

WATER DIVISION

Sketch of Service Here

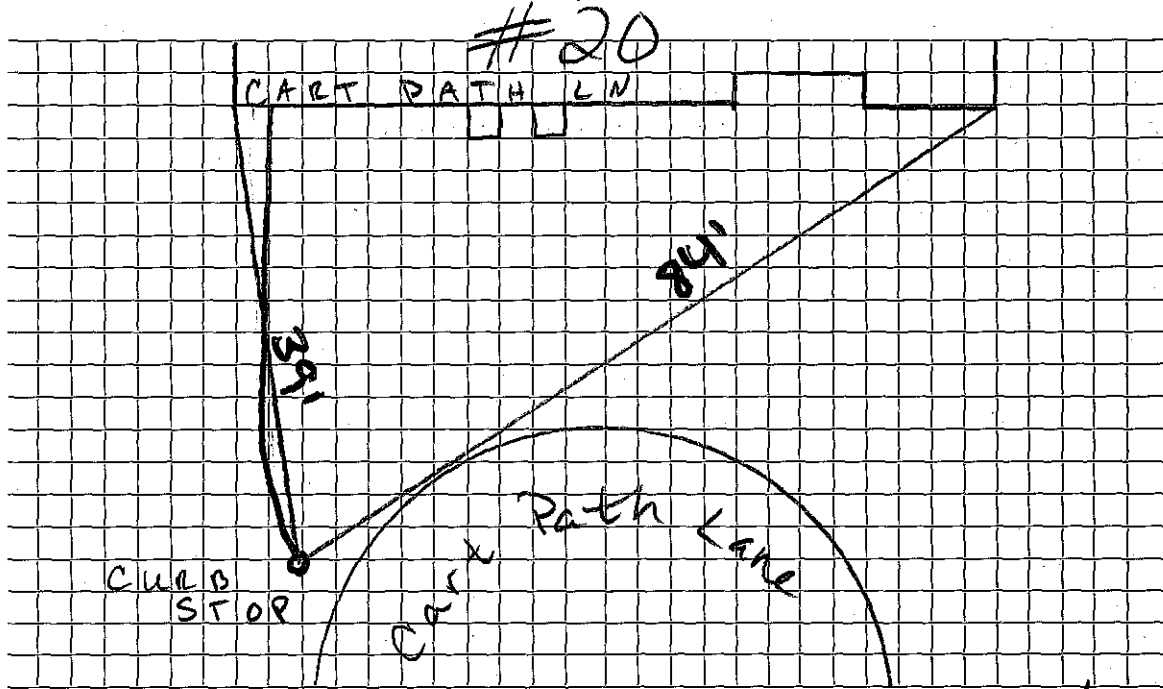

Connection made in Cart Path Ln Street. Work completed 9/5/2018

Remarks: .....

.....

.....