


DATE 1/9/19

TOWN OF LEXINGTON — BOARD OF PUBLIC WORKS

WATER DIVISION

Sketch of Service Here

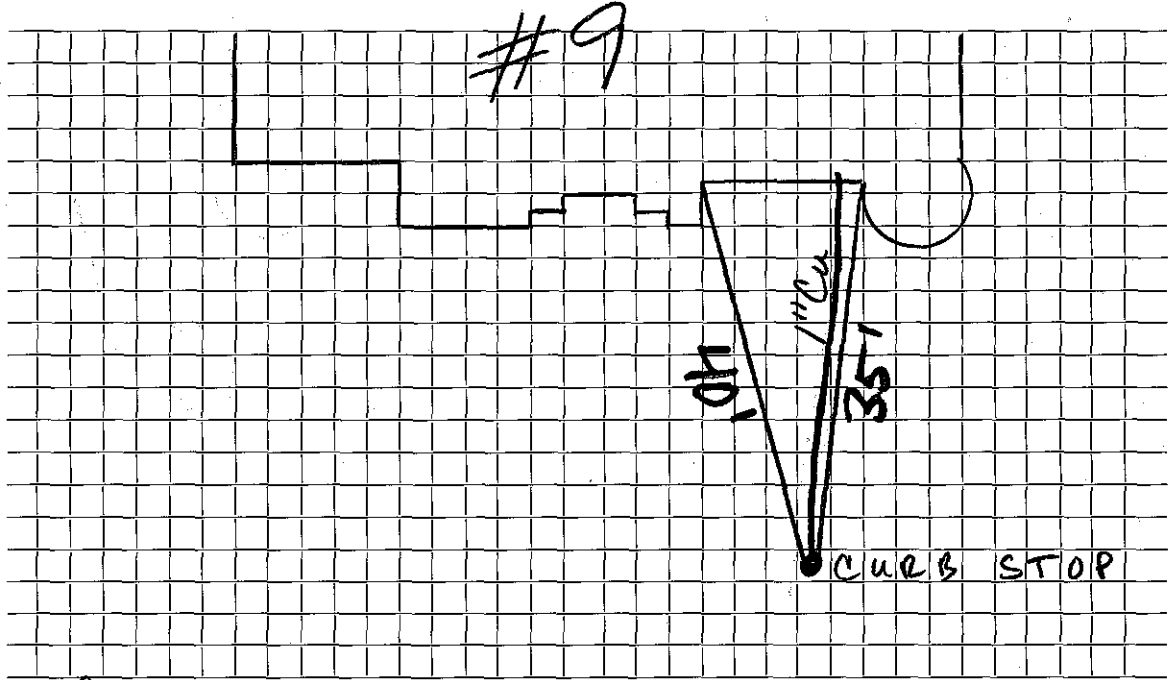

Connection made in Cart Path Ln Street. Work completed

Remarks: