

WATER SERVICE RECORD

4233

Name Harry G. Young

Service No. 16

Address 15 Carville Avenue

Location

~~Repair~~—Renewal—~~New Service~~ W.O. #7680

JUL 27 1970

Date	Material	Amount	Total	Date		Amount
5-13-70	Labor	44.61		5-7-70	Deposit	160.00
	10 % O.H.	4.46	49.07	7-27-70	Refund	65.16
23'	3/4" Copper tubing @.79		18.17			94.84
1	3/4" Wheel Valve		9.30		CURB TO MAIN	
1/8	yd loam		1.75	5-13-70	Labor	74.35
1/2	lb. Grass Seed		.55	6-17-70	"	29.46
1	hr. Trucking		3.00		20' 3/4" Copper tubing @.79	15.80
2	hr. Town Shovel @6.50		13.00		1/2 ton Cold Patch	2.93
			94.84		1 3/4" Curb Cock	11.32
					1 1/2 ton Hot Top	9.00
					3 1/2 hrs. Trucking	10.50
					1/2 hr. Compressor	2.00
					1/2 hr. Roller	1.50
					3 hrs. Backhoe	12.00
						168.86


DATE _____

TOWN OF LEXINGTON -- BOARD OF PUBLIC WORKS

WATER DIVISION

Sketch of Service Here

15 CARVILLE

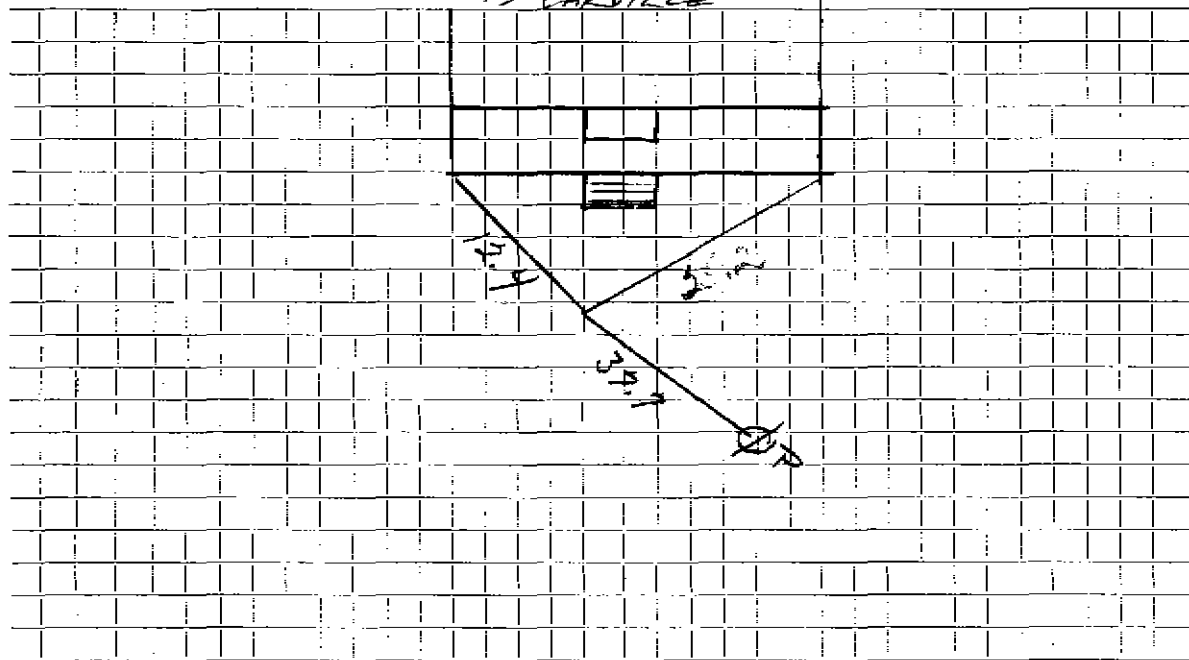

Connection made in Street. Work completed

Remarks:

.....
.....