

Name Josephine MacDonald

Service No.

38

Address 20 Carville Avenue

4621

Lexington, Mass.

Location 20 Carville Avenue

Kind of Pipe

Size

Size of Main

~~Repair~~ ~~Renewal~~ New Service Com. 5-2-49

Location

Date	Material	Amount	Total	Date	Amount
March 28, '49	Labor	1 15	1 15	March 28, '49	1 15
	10% Overhead		12		
	42' - 3/4" Copper Tubing @.27		11 34		
	1 - 3/4" C x 1/2" I.W.H. S&W		3 29		
	Trucking 1 hr. @.75		75		
			16 65		
				March 28, '49	1 15
				12' - 3/4" Copper Tubing @.27	3 24
				1 - 3/4" C Corp-cock	3 15
				1 - 3/4" C x 3/4" C Curb-cock	3 85
				1 - Box & Rod	3 95
				1 - 1/2" Offset Tail Piece	37
				1 - 1/2" Straight Tail Piece	37
				Trucking 1 hr. @.75	75
					16 83
	Labor				

Mar 24/49
May 5/49

Deposited
Refunded
Non-Charge

20 00
3 33

16 68

DATE _____

TOWN OF LEXINGTON - BOARD OF PUBLIC WORKS

WATER DIVISION

The undersigned applies for a supply of water at No..... St. and hereby agrees to comply with the rules and regulations as now, or at any future time, established by the Board of Selectmen.

Am't of Estimate \$.....

Owner


Am't Paid \$.....

Address

Builder

.....

Sketch of Service Here

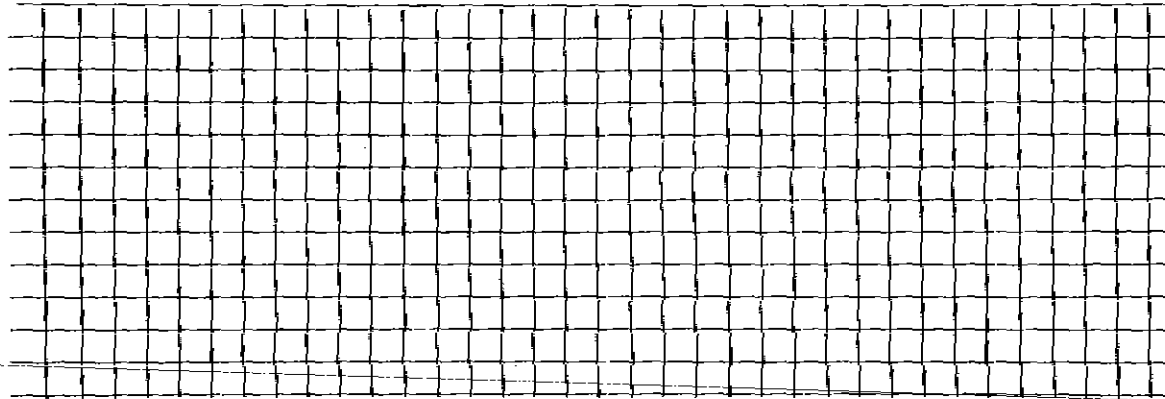

Connection made in Street.

Work completed19

Remarks: