

WATER SERVICE RECORD

Name N. Y. Brothers Trust

Service No. 25

Address 23 Carville Ave

Location

Repair—Renewal—New Service Valeri #3126 W.O.#1086

APR 8 1974

Date		Material	Amount	Total	Date	Amount
8-30-73	35'	3/4" Copper			7-24-73	100 00
					4-8-74	33 81
7-26-73		Labor	14.78		*	62 19
		10% O.H.	1.48	16.26		
	27'	3/4" Copper @ .60/ft.		16.20		
	1	3/4" Corporation		9.57		
	1	3/4" Curb cock		11.32		
	1	Box & rod		7.34		
	1	hr. Pickup @ 1.50		1.50		
				<u>\$62.19</u>		


* Applied to S.H. #73

DATE _____

TOWN OF LEXINGTON — BOARD OF PUBLIC WORKS

WATER DIVISION

Sketch of Service Here

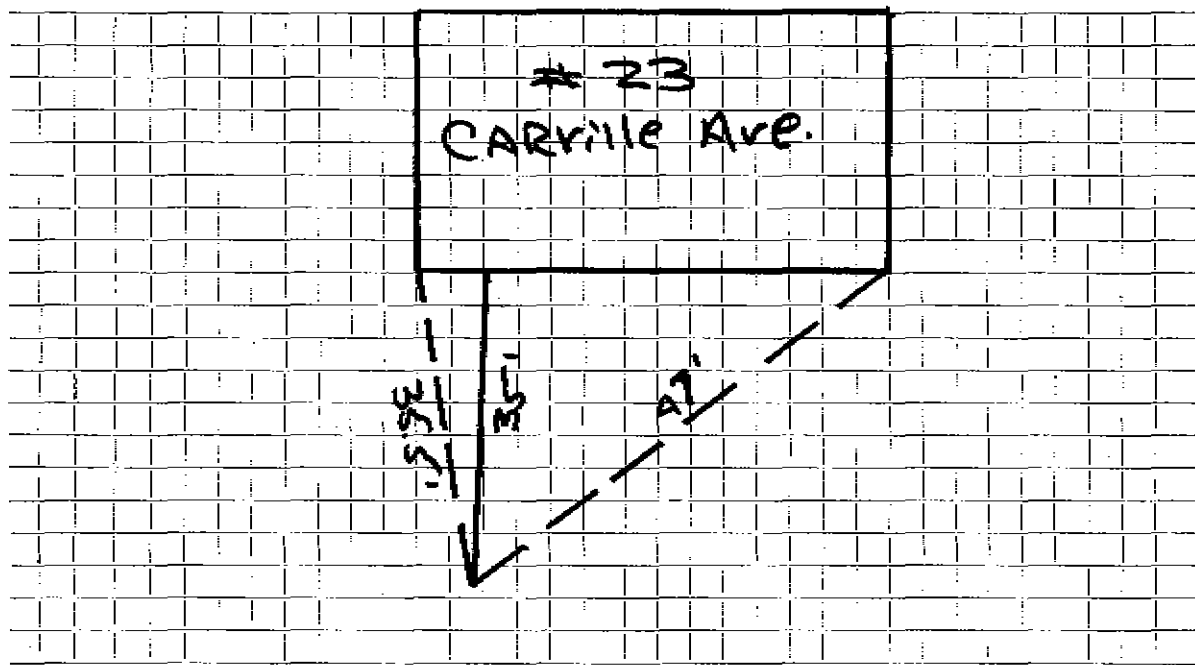

Connection made in Street. Work completed

Remarks:
.....
.....