

WATER SERVICE RECORD

Name D. B. Cameron

Service No. 183

Address 30 Carville Ave.

Location Lexington

Repair—Renewal—~~New Service~~

Conn 9-29-52


Date	Material	Amount	Total	Date	Amount
9/15/52	Labor	1 63		8-23-52	20 00
	10% Overhead	16	1 79	9-29-52	1 84
	45' - 3/4" Copper tubing@.34	15 30			<u>NON CHARGE</u>
	1 - 3/4" C x 1/2 I.W.H.stop&waste	4 00		9/15/52	Labor
	1 hr. trucking		75		1 63
			21 84	10'	3/4" Copper tubing@.34
					3 40
				1 - 3/4" C. corp-cock	4 33
				1 - 3/4" C x 3/4" C. curb-cock	4 67
				1 box and rod	3 90
8/23/67	WATER SERVICE KILLED - W.O. #5391			1 - 1/2 offset tail piece	50
				1 - 1/2 straight tail piece	50
				1 hr. trucking	75
					19 68

DATE _____

TOWN OF LEXINGTON — BOARD OF PUBLIC WORKS

WATER DIVISION

Sketch of Service Here

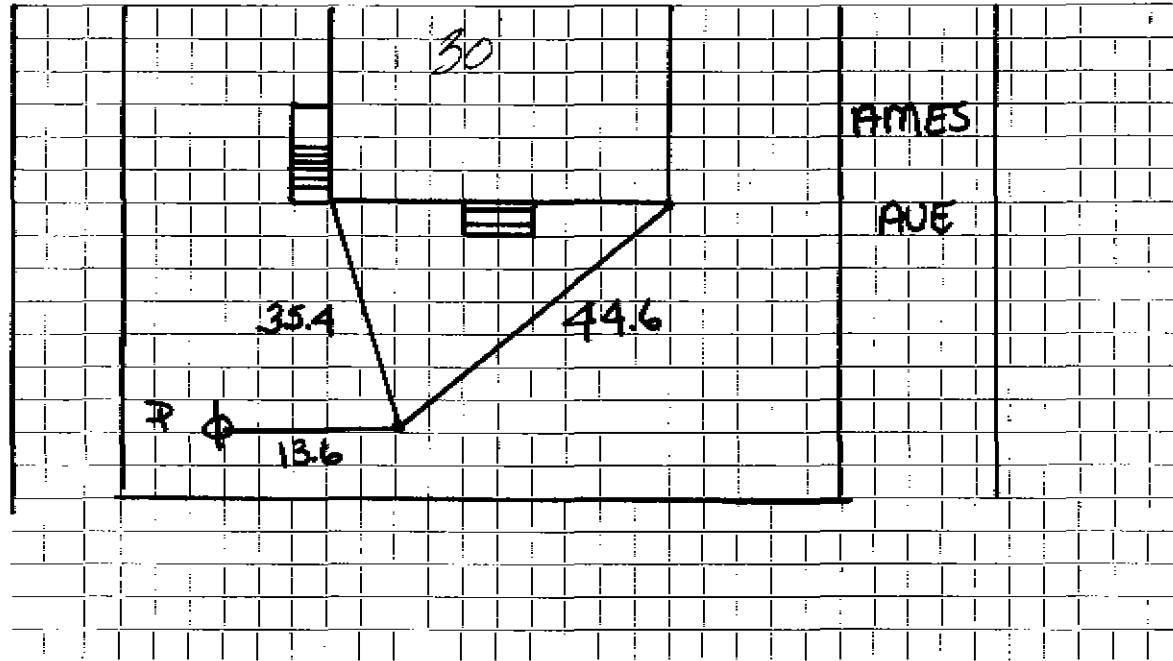

Connection made in Street. Work completed

Remarks:

.....

.....