

## WATER SERVICE RECORD

Name

Service No.

Address 31 Carville Ave.

Location

Repair—Renewal—New Service WO #4654


Date	Material	Amount	Total	Date	Amount
11-1-27	Charge for tap	5.00			
	3 hrs labor @ .55	1.65		1-3-28	Cash
			6.65		6.65
					OUTSIDE
				6/29/76	labor
					24½' 3/4" Copper @ .65
				1	3/4 Curb.
				1	3/4 Nipple
				1	3/4" X 1" Bushing
				1	3/4" repair clamp
				1	small corp. adpt.
					252.96

DATE \_\_\_\_\_

TOWN OF LEXINGTON — BOARD OF PUBLIC WORKS

**WATER DIVISION**

Sketch of Service Here

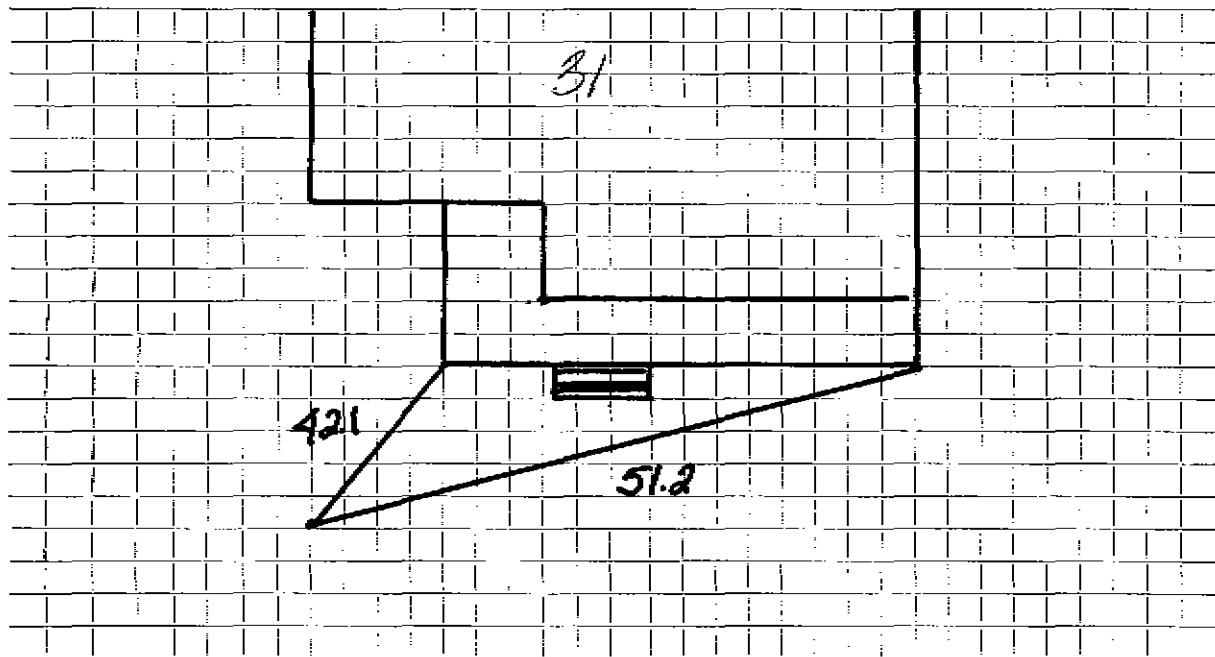

Connection made in ..... Street. Work completed .....

Remarks: .....  
.....  
.....