

## WATER SERVICE RECORD

#6379

Name William Sullivan

Service No. 74

Address 35 Carville Avenue

Location

~~Repair - Renewal~~ - New Service

Comm. 7/22/57


Date	Material	Amount	Total	Date	Amount
5/4/57	Labor	4 08		4-23-57	Deposit \$ 35 00
	10% overhead	41	4 49	7-22-57	Refund \$ 6 20
	44' - 3/4" Copper tubing @ .4228	18 60			NON CHARGE \$ 28 80
	1 hr. Trucking		75		Labor 2 04
	1 - 3/4" Cx 1/2 I.W.H. Stop & Waste	4 96	28 80	25' - 3/4" Copper tubing @ .4228	10 57
				1 - 3/4" C. Corp Cock	4 62
				1 - 3/4" C. Curb Cock	5 94
				1 Box & Rod	4 62
				1 - 1/2 Straight tailpiece	50
				1 - 1/2 Offset Tailpiece	50
				1/2 hr. Town Shovel @ 6.50	3 25
					32 04

DATE \_\_\_\_\_

TOWN OF LEXINGTON — BOARD OF PUBLIC WORKS

WATER DIVISION

Sketch of Service Here

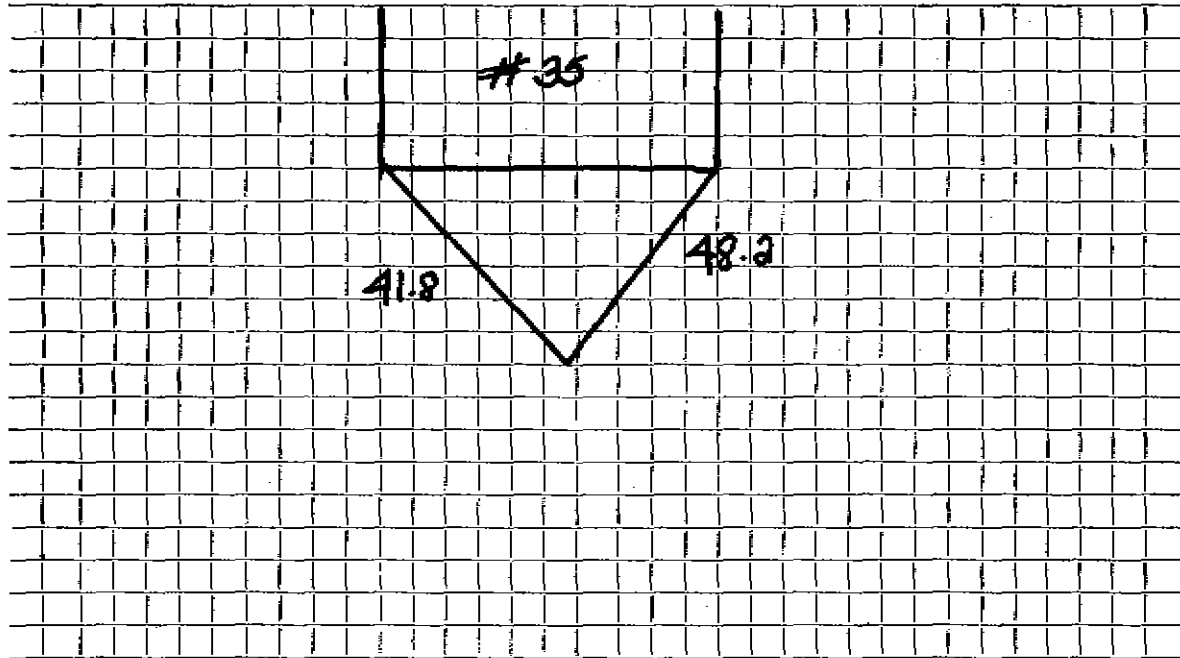

Connection made in ..... Street. Work completed .....

Remarks: .....

.....

.....