

Name Donald Cameron

1229

Service No. 64 465

Address 42 Carville Avenue

# 4760

Lexington, Mass.

Location 42 Carville Avenue

Kind of Pipe

Size

Size of Main

~~Repair~~—Renewal—~~New Service~~

Location

Date

Material

Amount

Total

Date

Amount

July 25, '46

Labor 9 58

9 58

*July 22, '46  
M 27 '46*

*Deposited  
Expended*

25 00

10% Overhead

96

3 69

19' - 3/4" Copper Tubing @ .1911

3 44

Non-Charge

19 31

1 - 1/4" C x 1/2" I.W.R. Stop & Waste 2 32

July 25, '46

Labor

9 45

Compressor 1 hr. @ 1.75

1 75

8' - 3/4" Copper Tubing

1 53

Trucking 1 hr. @ .75

75

1 - 3/4" C x 1/2" C Curb-cock

3 30

19 31

1 - 1/2" Copper Adapter

1 18

1 - 1/2" Offset Tail Piece

30

Trucking 1 hr. @ .75

75

17 11

Labor

Hadley Press, Inc., Lexington

## TOWN OF LEXINGTON—BOARD OF PUBLIC WORKS

### WATER DIVISION

The undersigned applies for a supply of water at No. \_\_\_\_\_ St. and hereby agrees to comply with the rules and regulations as now, or at any future time, established by the Board of Selectmen.


Am't. of Estimate \$ \_\_\_\_\_

Owner \_\_\_\_\_

Am't. Paid \$ \_\_\_\_\_

Address \_\_\_\_\_

Builder \_\_\_\_\_

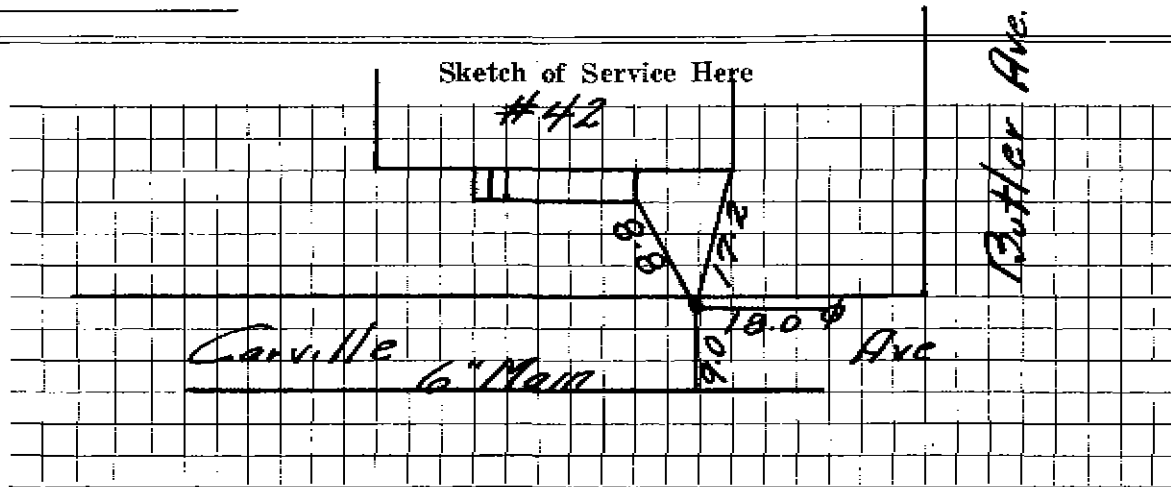

Connection made in \_\_\_\_\_ Street.

Work completed \_\_\_\_\_ 19

Remarks: