

Name Winfield Couette
 Address 6 & 8 Carville Avenue
 Lexington, Mass.

1440
 6646

Service No. 130
 # 421

Location 6 & 8 Carville Avenue

Kind of Pipe

Size

Size of Main

~~Repair - Renewal - New Service~~

Com. 9-26-49

Location

Date	Material	Amount	Total	Date	Location	Amount
Aug. 19, '49	Labor	14 00	14 00	Aug 9 '49	<i>Deposited</i> <i>Refunded</i> No Charge	30 00
	10% Overhead		1 40	Oct 6 '49		1 50
	30' - 1" Copper Tubing @ .302		9 06			28 50
	1 - 1" C x 3/4" I.W.H. S&W		3 29	Aug. 19, '49	Labor	18 40
	Trucking 1 hr. @ .75		75		11' - 1" Copper Tubing @ .302	3 32
			28 50		1 - 1" C Corp-cock	4 62
					1 - 1" C x 1" C Curb-cock	5 50
					1 - Box & Rod	3 75
					1 - 3/4" Offset Tail Piece	37
					1 - 3/4" Straight Tail Piece	37
					Littlefield Shovel 2 hrs. @ 7.00	14 00
					Trucking 1 hr. @ .75	75
					Patching 7 x 3	7 00
	Labor					58 08

DATE _____

TOWN OF LEXINGTON - BOARD OF PUBLIC WORKS

WATER DIVISION

The undersigned applies for a supply of water at No..... St. and hereby agrees to comply with the rules and regulations as now, or at any future time, established by the Board of Selectmen.

Am't of Estimate \$.....


Owner

Am't Paid \$.....

Address

Builder

Sketch of Service Here

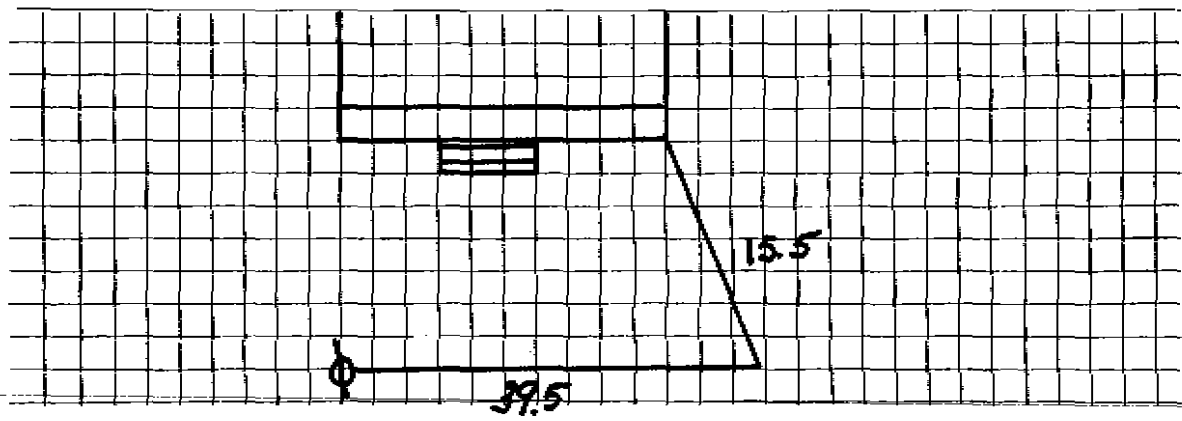

Connection made in Street.

Work completed19

Remarks: