

Name

Central Co-op. Bank

Service No.

# 459

Address

~~158 Highland Ave., Knoxville~~

# 5520

Location

7 Earville Ave.

Kind of Pipe

Size

Size of Main

~~Repair—Renewal—New Service~~

Location

Date

Material

Amount

Total

Date

Amount

8/30/35 Com. to Knoxville # 45.00-12-3-39	16 hrs. @ 50¢	8 00		Aug 28 1935	Deposited	45.00
	16 " @ 55¢	8 80				
	8 " @ 60¢	4 80				
	30' 1" C.L. Pipe @ 27¢	21 60		69.05	CT Outside 3/4 Copper	
	1 1" L.L. Coup. @	75				
	1 1" L.L. Ell	45				
	1 1" Brass Nipple	40				
	1 Stop & Waste	2 00				
	Trucking	1 00				
			69.80			

Labor

45 ft. @ \$1.00 - \$45.00  
45 ft. @ .45 - \$20.25

DATE \_\_\_\_\_

# TOWN OF LEXINGTON—BOARD OF PUBLIC WORKS

## WATER DIVISION

The undersigned applies for a supply of water at No. 74 Carville Ave. St. and hereby agrees to comply with the rules and regulations as now, or at any future time, established by the Board of Selectmen.

Am't. of Estimate \$ \_\_\_\_\_

Owner


Am't. Paid \$ \_\_\_\_\_

Address

Builder \_\_\_\_\_

*Central Cooperative Bank*  
*by J. J. Mc. Sully, Treas*  
*158 Highland Ave.,*  
*Somerville*

Sketch of Service Here

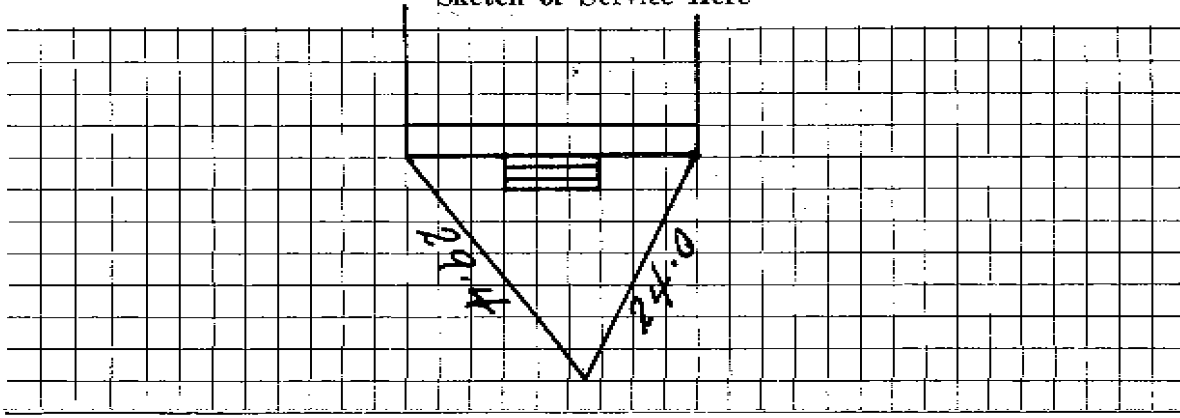

Connection made in \_\_\_\_\_ Street.

Work completed \_\_\_\_\_ 19

Remarks: