


DATE 11-8-96

TOWN OF LEXINGTON — BOARD OF PUBLIC WORKS
WATER DIVISION

Sketch of Service Here

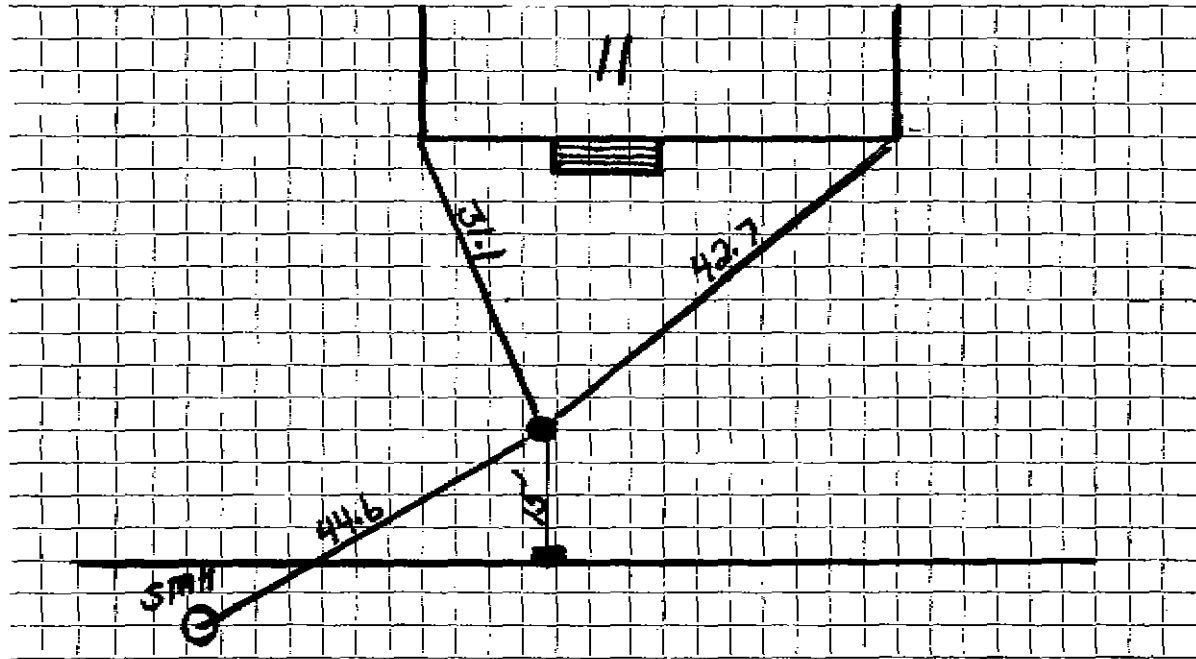

Connection made in Street. Work completed ... 8-27-96

Remarks: Original Service 10-20-33 - 4' deep at curb - 3' deep at house