

WATER SERVICE RECORD

Name

Service No.

Address 12 Cary Ave

Location

Repair—Renewal—New Service


Date	Material	Amount	Total	Date	Amount
9-18-50	Inside				Outside:
	45' 3/4" Copper			9-26-96	27' 1" Copper
	1 3/4" C. X 1/2" I.W.H.				1-1" Corp.
	5 Top & Waste				1-1" Curb.
					1-1x3/4 Adapt.
					1- Box

DATE _____

TOWN OF LEXINGTON — BOARD OF PUBLIC WORKS

WATER DIVISION

Sketch of Service Here

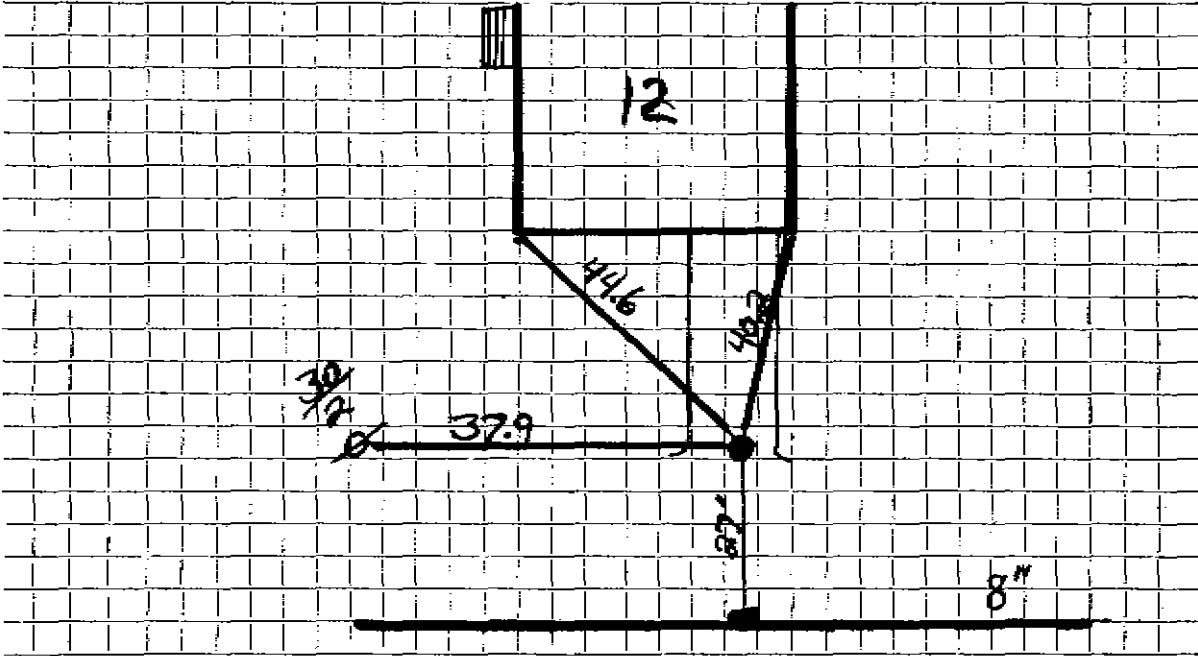

Connection made in Street. Work completed 9-26-96

Remarks:
.....
.....