

WATER SERVICE RECORD

Name

Service No.

Address 14 Cary Ave

Location


Repair—Renewal—New Service

Date	Material	Amount	Total	Date	Material	Amount
8-2-48	Inside				Outside	
65'	3/4" Copper			9-25-96	25.6-1" Copper	
	1 3/4" C. X 1/2" l.w.h. Stop & Waste				1-1" Corp.	
	1 3/4" C. X 3/4" C. - 3 Part Union				1-1" Curb	
					1-1 X 3/4 Adapt.	
					1-Box	

DATE _____

TOWN OF LEXINGTON — BOARD OF PUBLIC WORKS
WATER DIVISION

Sketch of Service Here

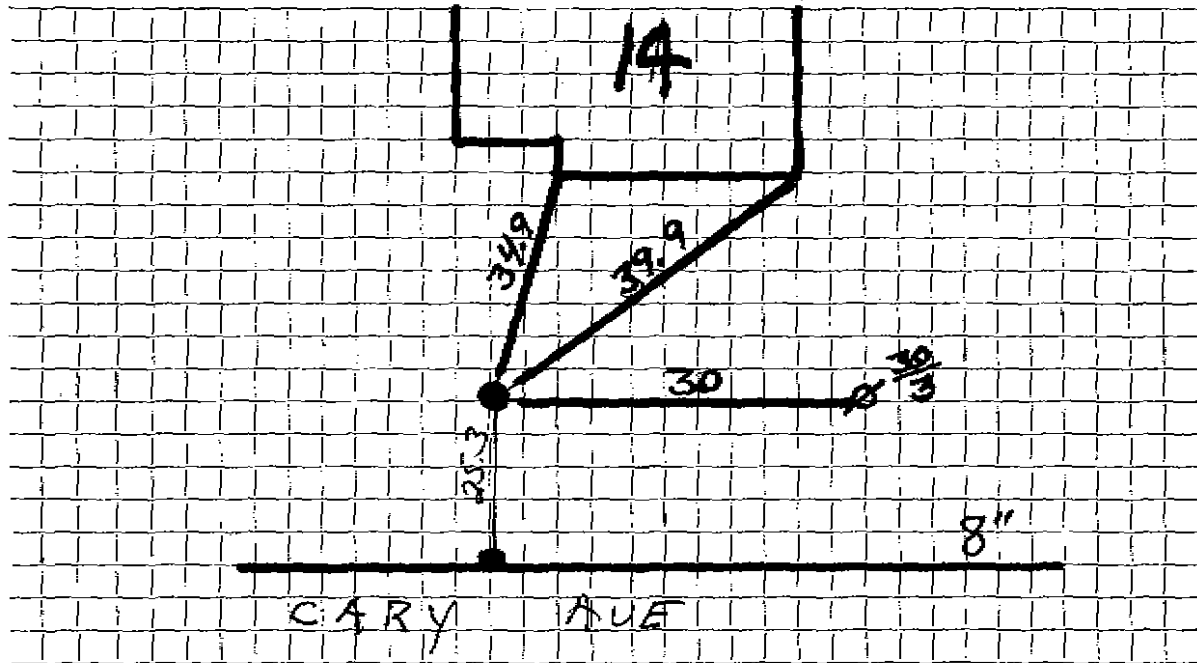

Connection made in Street. Work completed ... 9.25.96

Remarks:
.....
.....