

WATER SERVICE RECORD

Name

Service No.

Address *16 Cary*

Location


Repair—Renewal—New Service

Date	Material	Amount	Total	Date	Amount
8-21-48	Inside				
	65' ^{3"} / ₄ Copper			9-25-96	Outside
	1 ³ / ₄ " C. X ¹ / ₂ " I. W. H. Stop + Waste				27' 1" Copper
	1 ³ / ₄ " C. X ³ / ₄ " C. - 3 Part Union				1-1" Corp.
					1-1" Curb
					1-1 X ³ / ₄ Adapt.
					1- Box

DATE _____

TOWN OF LEXINGTON — BOARD OF PUBLIC WORKS
WATER DIVISION

Sketch of Service Here

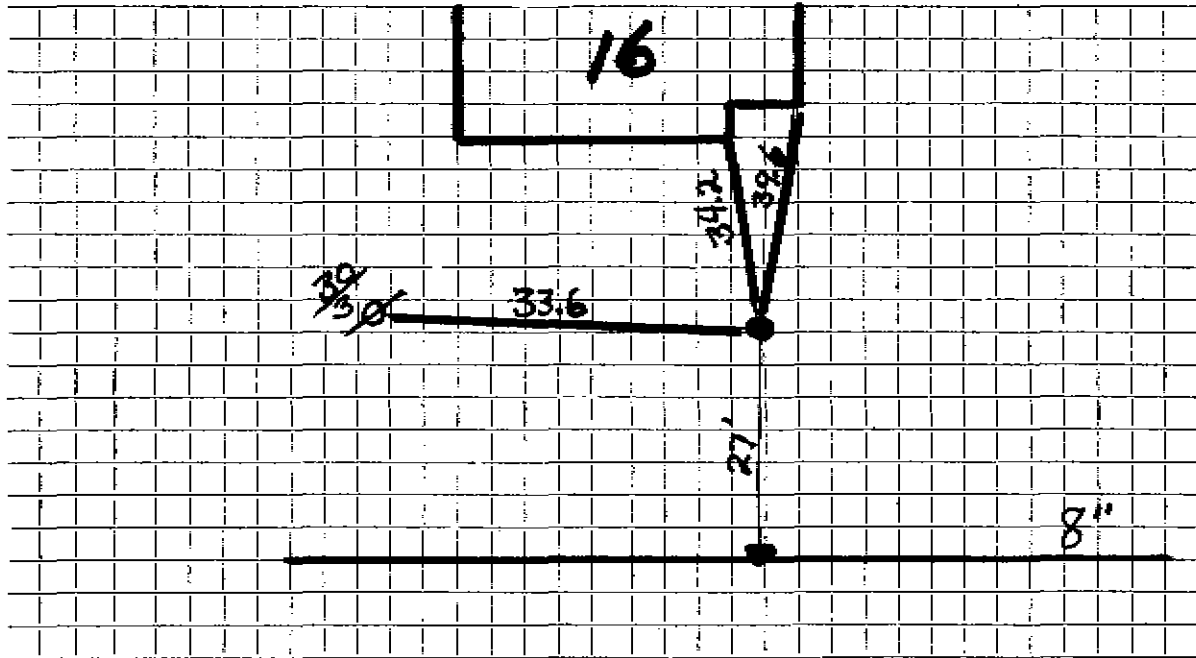

Connection made in Street. Work completed ... 9-25-96

Remarks:
.....
.....