

WATER SERVICE RECORD

Name

Service No.

Address 17 Cary Ave

Location


Repair—Renewal—New Service

Date	Material	Amount	Total	Date	Amount
7-24-33	Inside :				Outside :
	36' 1" Iron pipe			8-27-96	11'-1" Copper
	2 1" L.L. Coupling				1-1" Corp
	2 1" L.L. ELL				1-1" Curb.
	1 1" Br. Sp. Nipple				1- Box
	1 Stop + Waste				1-1" Cop to Iron

DATE 11-8-96

TOWN OF LEXINGTON — BOARD OF PUBLIC WORKS  
**WATER DIVISION**

Sketch of Service Here

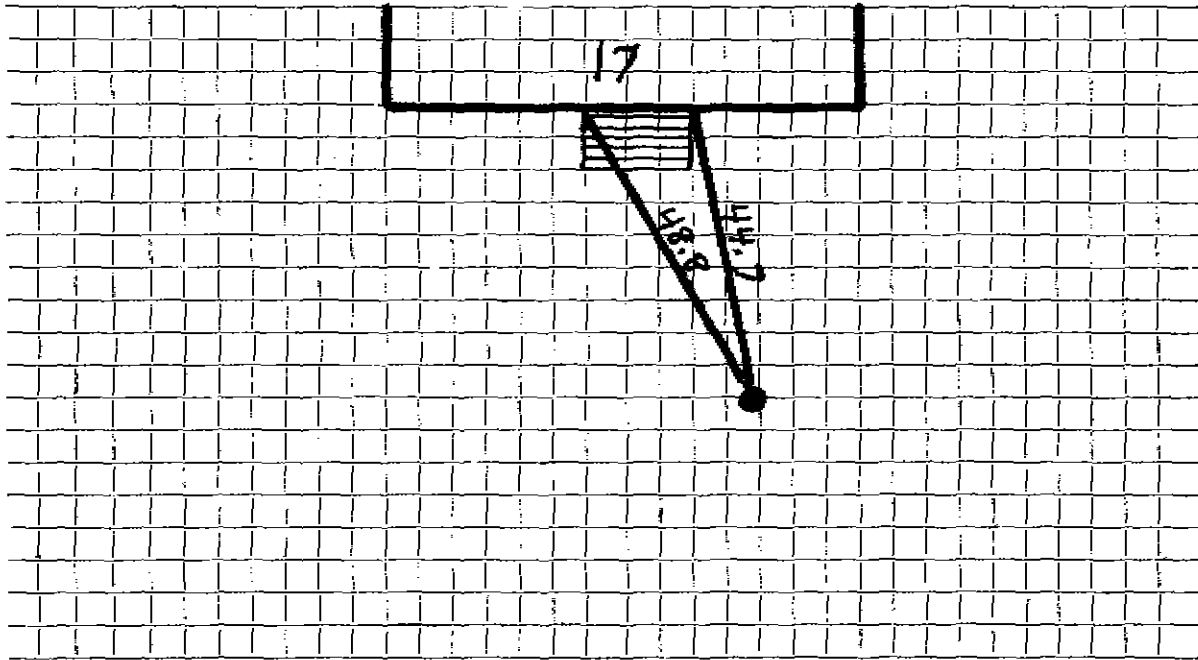

Connection made in ..... Street. Work completed 8-29-96 .....

Remarks: 10' OF 1" Copper Inside Curb. .....